

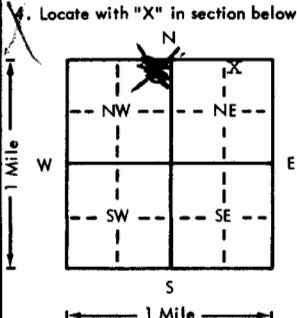
USE TYPEWRITER OR BALL  
POINT PEN-PRESS FIRMLY,  
PRINT CLEARLY.

WATER WELL RECORD  
KSA 82a-1201-1215

Kansas Department of Health and  
Environment-Division of Environment  
(Water well Contractors)  
Topeka, Kansas 66620

MT. JESUS NW

AAB

1. Location of well:	County Clark	Fraction NW 1/4 NE 1/4 NE 1/4	Section number 14	Township number T 30 S	Range number R 22 W
2. Distance and direction from nearest town or city: 13 North, 3 1/2 East, 3 North of Ashland, KS			3. Owner of well: Harold Kirk Bucklin, Kansas 67834		
4. Locate with "X" in section below: 			Sketch map:		
5. Type and color of material			6. Bore hole dia. 9 7/8 in. Completion date 6-26-76 Well depth 159 ft.		
Top soil			7. Cable tool X Rotary Driven Dug Hollow rod Jetted Bored Reverse rotary		
Clay			8. Use X Domestic Public supply Industry Irrigation Air conditioning Stock Lawn Oil field water Other		
Fine sand			9. Casing: Material PVC Height: Above or below Threaded Welded X Surface 12 in. RMP PVC Weight lbs./ft. Dia. 5 in. to 159 ft. depth Wall Thickness: inches or Dia. in. to ft. depth gage No. 265		
Med. to lar. sand			10. Screen: Manufacturer's name Jess & Lowell Type PVC Dia. 5 in. Slot/gauze 1/8 in. Length 40 in. Set between 119 ft. and 159 ft. Gravel pack? yes Size range of material 3/16 in.		
Limestone & sand stone			11. Static water level: mo./day/yr. 110 ft. below land surface Date 6/21/76		
Med. to lar. sand			12. Pumping level below land surfaces: ft. after hrs. pumping g.p.m. ft. after hrs. pumping g.p.m. Estimated maximum yield g.p.m.		
BROCK 159 110 49' thick			13. Water sample submitted: mo./day/yr. Yes X No Date		
in g			14. Well head completion: X Pitless adapter 12 inches above grade		
			15. Well grouted? yes With: Neat cement Bentonite X Concrete Depth: From 0 ft. to 10 ft.		
			16. Nearest source of possible contamination: ft. 100 Direction southwest old well Well disinfected upon completion? X Yes No		
			17. Pump: Windmill Tower Not installed Manufacturer's name Model number HP Volts Length of drop pipe 147 ft. capacity 3 g.p.m. Type: Submersible Turbine Jet Reciprocating Centrifugal X Other		
18. Elevation:			20. Water well contractor's certification: This well was drilled under my jurisdiction and this report is true to the best of my knowledge and belief. Friesen Windmill 252 Business name License No. Address Meade, Kansas 67864 Signed [Signature] Date 6-30-76 Authorized representative		
19. Remarks: TOPO					

(Use a second sheet if needed)

2410  
159  
251

30 22 W 14 N 22 E

Forward the white, blue and pink copies to the Department of Health and Environment

Form WWC-5