


1 LOCATION OF WATER WELL: County: **Clark** Fraction: **E¹/₂ 1/4 E¹/₂ 1/4 NE 1/4** Section Number: **15** Township Number: **T 30 S** Range Number: **R 22 -E/W**

Distance and direction from nearest town or city street address of well if located within city?
6 south 3 east of Kingsdown

2 WATER WELL OWNER: **David White**
 RR#, St. Address, Box #: **Kingsdown, Ks.**
 City, State, ZIP Code: **Wichita, Ks. 67202**
 Board of Agriculture, Division of Water Resources
 Application Number: **T83-197**

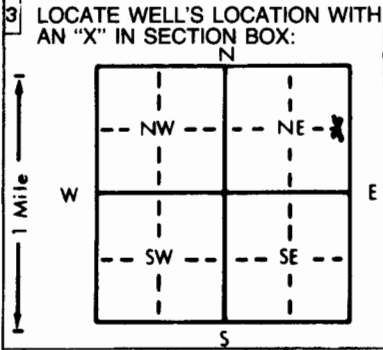

4 DEPTH OF COMPLETED WELL: **152** ft. ELEVATION: _____
 Depth(s) Groundwater Encountered: 1. **70** ft. 2. _____ ft. 3. _____ ft.
 WELL'S STATIC WATER LEVEL: **95** ft. below land surface measured on mo/day/yr **5-31-83**
 Pump test data: Well water was _____ ft. after _____ hours pumping _____ gpm
 Est. Yield: **NA** gpm: Well water was _____ ft. after _____ hours pumping _____ gpm
 Bore Hole Diameter: **10** in. to **152** ft., and _____ in. to _____ ft.
 WELL WATER TO BE USED AS:
 1 Domestic 2 Irrigation 3 Feedlot 4 Industrial 5 Public water supply 6 Oil field water supply 7 Lawn and garden only 8 Air conditioning 9 Dewatering 10 Observation well 11 Injection well 12 Other (Specify below)
 Was a chemical/bacteriological sample submitted to Department? Yes _____ No _____; If yes, mo/day/yr sample was submitted _____
 Water Well Disinfected? Yes **HTH** No _____

5 TYPE OF BLANK CASING USED:
 1 Steel 2 PVC 3 RMP (SR) 4 ABS 5 Wrought iron 6 Asbestos-Cement 7 Fiberglass 8 Concrete tile 9 Other (specify below) CASING JOINTS: Glued Clamped _____
 Blank casing diameter: **5** in. to **120** ft., Dia _____ in. to _____ ft., Dia _____ in. to _____ ft.
 Casing height above land surface: **18** in., weight _____ lbs./ft. Wall thickness or gauge No. **258**
 TYPE OF SCREEN OR PERFORATION MATERIAL:
 1 Steel 2 Brass 3 Stainless steel 4 Galvanized steel 5 Fiberglass 6 Concrete tile 7 PVC 8 RMP (SR) 9 ABS 10 Asbestos-cement 11 Other (specify) _____ 12 None used (open hole)
 SCREEN OR PERFORATION OPENINGS ARE:
 1 Continuous slot 2 Louvered shutter 3 Mill slot 4 Key punched 5 Gauzed wrapped 6 Wire wrapped 7 Torch cut 8 Saw cut 9 Drilled holes 10 Other (specify) _____ 11 None (open hole)
 SCREEN-PERFORATED INTERVALS: From **120** ft. to **152** ft., From _____ ft. to _____ ft.
 GRAVEL PACK INTERVALS: From **10** ft. to **152** ft., From _____ ft. to _____ ft.

6 GROUT MATERIAL: 1 Neat cement 2 Cement grout 3 Bentonite 4 Other _____
 Grout Intervals: From _____ ft. to _____ ft., From _____ ft. to _____ ft.
 What is the nearest source of possible contamination:
 1 Septic tank 2 Sewer lines 3 Watertight sewer lines 4 Lateral lines 5 Cess pool 6 Seepage pit 7 Pit privy 8 Sewage lagoon 9 Feedyard 10 Livestock pens 11 Fuel storage 12 Fertilizer storage 13 Insecticide storage 14 Abandoned water well 15 Oil well/Gas well 16 Other (specify below) _____
 Direction from well? **west** How many feet? **80**

FROM	TO	LITHOLOGIC LOG	FROM	TO	LITHOLOGIC LOG
0	3 ⁰¹	Dark top soil			
3	25 ³⁵	Tan clay w/white broken rock			
25	33 ⁰⁴	Tan sandy clay w/white broken rock			
33	70 ⁰⁷	Fine sand			
70	98 ⁰⁸	Medium sand			
98	102 ⁰¹	Tan clay			
102	148 ⁰⁰	Medium sand			
148	152 ¹⁹	Yellow clay w/shale			

7 CONTRACTOR'S OR LANDOWNER'S CERTIFICATION: This water well was (1) constructed, (2) reconstructed, or (3) plugged under my jurisdiction and was completed on (mo/day/year) **5-31-83** and this record is true to the best of my knowledge and belief. Kansas Water Well Contractor's License No. **134** This Water Well Record was completed on (mo/day/yr) **6-27-83** under the business name of **Rosencrantz-Bemis Ent.** by signature **Dora Dodson**

INSTRUCTIONS: Use typewriter or ball point pen, PLEASE PRESS FIRMLY and PRINT clearly. Please fill in blanks, underline or circle the correct answers. Send top three copies to Kansas Department of Health and Environment, Division of Environment, Environmental Geology Section, Topeka, KS 66620. Send one to WATER WELL OWNER and retain one for your records.

OFFICE USE ONLY
T 30 S R 22 E 1/4 E 1/4 NE 1/4

DD