USE TYPEWRITER OR BALL POINT PEN-PRESS FIRMLY, PRINT CLEARLY.

BLOOM

WATER WELL RECORD
KSA 82a-1201-1215

-BBTS

T	R	EW	sec 1/4	1/4	1/4	No.

Kansas State Dept. Of Health
(Water Well Contractors)
Forbes-Bldg. 740
Topeka, Kansas 66620

1 Location of well:	County	Township name	Fraction	Section number	Town number	Range number
	Clark	Appleton	NW NW NW ~~NW¼ of NW¼~~	30	T-30-S	R-23-W

Distance and direction from nearest town or city: 5 mi south & 1 mi east of Bloom

Street address of well location if in city:

3 Owner of well: Tony Beard

Address: Minneola, Ks

Locate with "X" in section below:

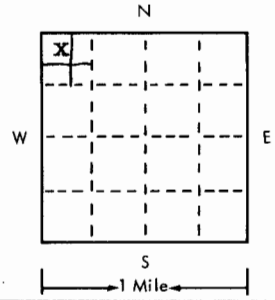

Sketch map:

2 Type and color of material	From	To
Surface	0	3
A-1 sand and gravel	3	75
Blue shale	75	90
BROK 75'		
14/61' sat thick		

(use a second sheet if needed)

4 Well depth: 80 ft. Date of completion 10-20-75
Well diameter 28" in.

5 ☐ Cable tool ☐ Rotary ☐ Driven ☐ Dug ☐ Hollow rod ☐ Jetted ☐ Bored ☒ Reverse rotary

6 Use: ☐ Domestic ☐ Public supply ☐ Industry ☒ Irrigation ☐ Air conditioning ☐ Commercial ☐ Test well ☐

7 Casing: Material Metal Height: above/below
Threaded ☐ Welded ☒ Surface 12 in.
Diam. 16 in. to 80 ft. depth Weight 30.30 lb./ft. 1
___ in. to ___ ft. depth Drive shoe? ☐ Yes ☒ No

8 Screen:
Manufacturer WA Brown
Type Freeflo Dia. 16
Slot/gauze 178 Length 2"
Set between 10 ft. and 80 ft.
Fittings:
Gravel pack ☒ Yes ☐ No Size range of material CMA

9 Static water level:
14 ft. below land surface Date 10-20-75

10 Pumping level below land surfaces:
23 ft. after 1 hrs. pumping 400 g.p.m.
70 ft. after 1 hrs. pumping 1,000 g.p.m.
Estimated maximum yield ~~1000~~ g.p.m.

11 Water sample submitted:
☐ Yes ☒ No Date ___

12 Well head completion:
☐ Pitless adapter ☒ Inches above grade

13 Well grouted? ☒ Yes ☐ No
☒ Neat cement ☐ Bentonite ☐
Depth: From 0 ft. to 10 ft.

14 Nearest source of possible contamination:
ft. 600 Direction North Type Creek
Well disinfected upon completion? ☐ Yes ☒ No

15 Pump: ☐ Not installed
Manufacturer's name Goulds
Model number 10JLO HP 30 Volts 480
Length of drop pipe 70 ft. capacity 350 g.m.p.
Type:
☐ Submersible ☒ Turbine
☐ Jet ☐ Reciprocating
☐ Certrifugal ☐ Other

16 Remarks: elevation

Topography:
☐ Hill
☐ Slope
☐ Upland
☒ Valley

TOPO

24/65
75
2390

17 Water well contractor's certification:
This well was drilled under my jurisdiction and this report is true to the best of my knowledge and belief.
Ace-Hi Int. Inc. License No. 190
Business name
Address Dodge City, Ks
Signed Carl G. Little Date 11-8-75
Authorized representative

30 23W 30 NW NW NW

Forward the white, blue and pink copies to the Kansas State Dept. Of Health.

Form WWC-5

677-H