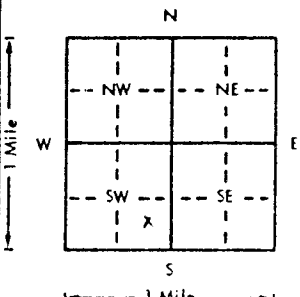


USE TYPEWRITER OR BALL POINT PEN-PRESS FIRMLY, PRINT CLEARLY.

WATER WELL RECORD
KSA 82a-1201-1215

Kansas Department of Health and Environment-Division of Environment
(Water well Contractors)
Topeka, Kansas 66620

1. Location of well:	County CLARK	Fraction 1/4 SW 1/4 SW 1/4	Section number 5	Township number T 30 S	Range number R 25 EW
2. Distance and direction from nearest town or city: 1 m N Minneola - 3 1/4 m W 1/4 N Street address of well location if in city:			3. Owner of well: E. T. Wears R.R. or street: City, state, zip code: Minneola Kansas 67865		
4. Locate with "X" in section below: 			Sketch map:		
5. Type and color of material			From	To	6. Bore hole dia. 9 in. Completion date 4/18/80 Well depth 135 ft.
OVER BURDEN			0	55	7. <input checked="" type="checkbox"/> Cable tool <input checked="" type="checkbox"/> Rotary <input type="checkbox"/> Driven <input type="checkbox"/> Dug <input type="checkbox"/> Hollow rod <input type="checkbox"/> Jetted <input type="checkbox"/> Bored <input type="checkbox"/> Reverse rotary
MEDIUM TO COARSE SAND			55	80	8. Use: <input type="checkbox"/> Domestic <input type="checkbox"/> Public supply <input type="checkbox"/> Industry <input type="checkbox"/> Irrigation <input type="checkbox"/> Air conditioning <input type="checkbox"/> Stock <input type="checkbox"/> Lawn <input checked="" type="checkbox"/> Oil field water <input type="checkbox"/> Other
FINE SAND & CLAY			80	105	9. Casing: Material PVC Height: <input type="checkbox"/> Above or below Threaded <input type="checkbox"/> Welded <input type="checkbox"/> Surface 14 in. RMP <input type="checkbox"/> PVC lined <input checked="" type="checkbox"/> Weight _____ lbs./ft. Dia. 5 in. to 51 ft. depth Wall Thickness: inches or Dia. _____ in. to _____ ft. depth gauge No. 0258
RED BED & FINE SAND			105	125	10. Screen: Manufacturer's name _____ Peerless Type PVC Dia. 5 Slot/gauze 1/16 Length 84 Set between 51 ft. and 135 ft. ft. and _____ ft. Gravel pack? <input checked="" type="checkbox"/> Yes Size range of material 1/8
BLUE SHALE			125	135	11. Static water level: _____ mo./day/yr. 5 ft. below land surface Date 11/18/80
					12. Pumping level below land surfaces: _____ ft. after _____ hrs. pumping _____ g.p.m. _____ ft. after _____ hrs. pumping _____ g.p.m. Estimated maximum yield 70 g.p.m.
					13. Water sample submitted: _____ mo./day/yr. <input type="checkbox"/> Yes <input checked="" type="checkbox"/> No Date _____
					14. Well head completion: <input type="checkbox"/> Pitless adapter 14 Inches above grade
					15. Well grouted? <input checked="" type="checkbox"/> Yes With: <input checked="" type="checkbox"/> Neat cement <input type="checkbox"/> Bentonite <input type="checkbox"/> Concrete Depth: From 3 ft. to 13 ft.
					16. Nearest source of possible contamination: none ft. _____ Direction _____ Type _____ Well disinfected upon completion? <input checked="" type="checkbox"/> Yes <input type="checkbox"/> No
					17. Pump: _____ Not installed Manufacturer's name Goulds Model number UTM34HP 3 Volts 230 Length of drop pipe 100 ft. capacity _____ g.p.m. Type: <input checked="" type="checkbox"/> Submersible <input type="checkbox"/> Turbine <input type="checkbox"/> Jet <input type="checkbox"/> Reciprocating <input type="checkbox"/> Centrifugal <input type="checkbox"/> Other
			(Use a second sheet if needed)		
18. Elevation: Topography: <input type="checkbox"/> Hill <input type="checkbox"/> Slope <input checked="" type="checkbox"/> Upland <input type="checkbox"/> Valley	19. Remarks: 16. drilled in pasture 17. Pumped water 15 days - Pulled pump - capped well		20. Water well contractor's certification: This well was drilled under my jurisdiction and this report is true to the best of my knowledge and belief. T-W WATER WELL CO Business name Box 816 Liberal KS 67861 License No. _____ Address _____ Signed Chad Marsteller Date 4/28/80 Authorized representative		