


LOCATION OF WATER WELL:		Fraction	SE	1/4	SE	1/4	SW	1/4	Section Number	12	Township Number	T 30	S	Range Number	R 25	SW
-------------------------	--	----------	----	-----	----	-----	----	-----	----------------	----	-----------------	------	---	--------------	------	----

Distance and direction from nearest town or city street address of well if located within city?

1/8 Mile East of Minneola, Kansas

2] WATER WELL OWNER:	Mr. Bruce Hensley	
RR#, St. Address, Box # :	Route #1	Board of Agriculture, Division of Water Resources
City, State, ZIP Code :	Bloom KS 67833	Application Number: ----

LOCATE WELL'S LOCATION WITH AN "X" IN SECTION BOX: 4 DEPTH OF COMPLETED WELL: 140 ft. ELEVATION: Level

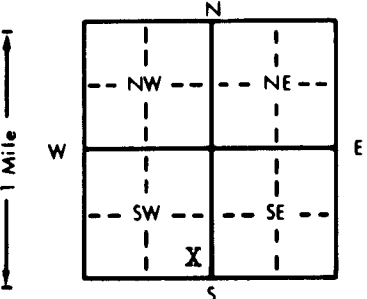

4 DEPTH OF COMPLETED WELL... 140 ft. ELEVATION: Level
 Depth(s) Groundwater Encountered 1. Not available ft. 2. ft. 3. ft.
 WELL'S STATIC WATER LEVEL ... 75 ft. below land surface measured on mo/day/yr June 29, 1988 ...
 Pump test data: Well water was ft. after hours pumping gpm
 Est. Yield . 20 gpm: Well water was ft. after hours pumping gpm
 Bore Hole Diameter... 10 in. to ... 140 ft., and in. to ft.
 WELL WATER TO BE USED AS: 5 Public water supply 8 Air conditioning 11 Injection well
 XX Domestic 3 Feedlot 6 Oil field water supply 9 Dewatering 12 Other (Specify below)
 2 Irrigation 4 Industrial 7 Lawn and garden only 10 Observation well
 Was a chemical/bacteriological sample submitted to Department? Yes.....No.. XX.....; If yes, mo/day/yr sample was sub-
 mitted Water Well Disinfected? Yes XX No

5 TYPE OF BLANK CASING USED:		5 Wrought iron	8 Concrete tile	CASING JOINTS: Glued <u>XX</u> . . . Clamped . . .
1 Steel	3 RMP (SR)	6 Asbestos-Cement	9 Other (specify below)	Welded . . .
<u>XX</u> PVC	4 ABS	7 Fiberglass		Threaded . . .
Blank casing diameter . . . 5 . . . in. to . . . 100 . . . ft. Dia . . . in. to . . . ft. Dia . . . in. to . . . ft.				
Casing height above land surface . . . 15 . . . in. weight . . . 2.8 . . . lbs./ft. Wall thickness or gauge No. . . 265				

TYPE OF SCREEN OR PERFORATION MATERIAL:			X PVC	10 Asbestos-cement
1 Steel	3 Stainless steel	5 Fiberglass	8 RMP (SR)	11 Other (specify)
2 Brass	4 Galvanized steel	6 Concrete tile	9 ABS	12 None used (open hole)

SCREEN OR PERFORATION OPENINGS ARE:		5 Gauzed wrapped	XXX Saw cut	11 None (open hole)
1 Continuous slot	3 Mill slot	6 Wire wrapped	9 Drilled holes	
2 Louvered shutter	4 Key punched	7 Torch cut	10 Other (specify)	


SCREEN-PERFORATED INTERVALS:	From 100 ft. to 140 ft.,	From ft. to ft.
	From ft. to ft.,	From ft. to ft.
GRAVEL PACK INTERVALS:	From 20 ft. to 140 ft.,	From ft. to ft.
	From ft. to ft.,	From ft. to ft.

6	GROUT MATERIAL:		1 Neat cement	2 Cement grout	3 Bentonite	<input checked="" type="checkbox"/> Other	Baroid Hole Plug				
	Grout Intervals:	From	0	ft. to	20	ft.	From		ft. to		ft.

What is the nearest source of possible contamination:				10 Livestock pens	14 Abandoned water well
XX Septic tank	4 Lateral lines	7 Pit privy	11 Fuel storage	15 Oil well/Gas well	
2 Sewer lines	5 Cess pool	8 Sewage lagoon	12 Fertilizer storage	16 Other (specify below)	
3 Watertight sewer lines	6 Seepage pit	9 Feedyard	13 Insecticide storage	

Direction from well?	West	How many feet?	100
----------------------	------	----------------	-----

[illegible]

7 CONTRACTOR'S OR LANDOWNER'S CERTIFICATION: This water well was (1) constructed, (2) reconstructed, or (3) plugged under my jurisdiction and was completed on (mo/day/year) June 30, 1988 and this record is true to the best of my knowledge and belief. Kansas Water Well Contractor's License No. 252 This Water Well Record was completed on (mo/day/yr) July 11, 1988 under the business name of FRIESEN WINDMILL & SUPPLY INC. by (signature) 

INSTRUCTIONS: Use typewriter or ball point pen. PLEASE PRESS FIRMLY and PRINT clearly. Please fill in blanks, underline or circle the correct answers. Send top three copies to Kansas Department of Health and Environment, Bureau of Water Protection, Topeka, Kansas 66620-7320, Telephone: 913-862-9360. Send one to WATER WELL OWNER and retain one for your records.

10-8700000243