

WATER WELL RECORD Form WWC-5 KSA 82a-1212


1 LOCATION OF WATER WELL: Fraction  $\frac{1}{4}$  CNW  $\frac{1}{4}$  SW  $\frac{1}{4}$  Section Number 15 Township Number T 30 Range Number R 25 EW

County: CLARK Distance and direction from nearest town or city street address of well if located within city?

2W Minnedaca 1/2 N.

2 WATER WELL OWNER: Muffin Whelling M.E. Goyen L. Goyen  
 RR#, St. Address, Box #: Box 183  
 City, State, ZIP Code: Pratt, Ks. 67124  
 Board of Agriculture, Division of Water Resources  
 Application Number: 783-129

3 LOCATE WELL'S LOCATION WITH AN "X" IN SECTION BOX: 4 DEPTH OF COMPLETED WELL: 160 ft. ELEVATION: 160 ft.

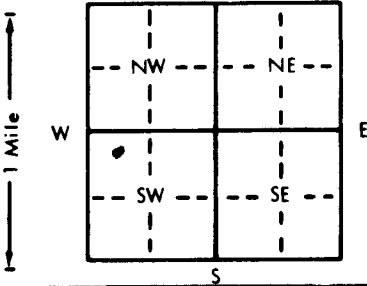

Depth(s) Groundwater Encountered 1. 65 ft. 2. 65 ft. 3. 65 ft.  
 WELL'S STATIC WATER LEVEL 65 ft. below land surface measured on mo/day/yr 3/25/83  
 Pump test data: Well water was 140 ft. after 2 hours pumping 60 gpm  
 Est. Yield 60 gpm Well water was 140 ft. after 2 hours pumping 60 gpm  
 Bore Hole Diameter 9 in. to 160 ft., and 160 in. to 160 ft.  
 WELL WATER TO BE USED AS:  
 1 Domestic 3 Feedlot 6 Oil field water supply 9 Dewatering 11 Injection well  
 2 Irrigation 4 Industrial 7 Lawn and garden only 10 Observation well 12 Other (Specify below)  
 Was a chemical/bacteriological sample submitted to Department? Yes No; If yes, mo/day/yr sample was submitted Water Well Disinfected? Yes No

5 TYPE OF BLANK CASING USED:  
 1 Steel 3 RMP (SR) 5 Wrought iron 8 Concrete tile CASING JOINTS: Glued Clamped  
 2 PVC 4 ABS 6 Asbestos-Cement 9 Other (specify below) Welded  
 7 Fiberglass Threaded

Blank casing diameter 5 in. to 60 ft. Dia. 200 in. to 200 ft. Dia. 0.265 in. to 0.265 ft.  
 Casing height above land surface 2 ft. weight 200 lbs./ft. Wall thickness or gauge No. 0.265

TYPE OF SCREEN OR PERFORATION MATERIAL:  
 1 Steel 3 Stainless steel 5 Fiberglass 8 RMP (SR) 10 Asbestos-cement  
 2 Brass 4 Galvanized steel 6 Concrete tile 9 ABS 11 Other (specify)  
 12 None used (open hole)

SCREEN OR PERFORATION OPENINGS ARE:  
 1 Continuous slot 3 Mill slot 5 Gauzed wrapped 8 Saw cut 11 None (open hole)  
 2 Louvered shutter 4 Key punched 6 Wire wrapped 9 Drilled holes  
 7 Torch cut 10 Other (specify)

SCREEN-PERFORATED INTERVALS: From 60 ft. to 160 ft. From 60 ft. to 160 ft.  
 GRAVEL PACK INTERVALS: From 55 ft. to 160 ft. From 55 ft. to 160 ft.

6 GROUT MATERIAL: 1 Neat cement 2 Cement grout 3 Bentonite 4 Other  
 Grout Intervals: From 0 ft. to 10 ft. From 0 ft. to 10 ft.

What is the nearest source of possible contamination:  
 1 Septic tank 4 Lateral lines 7 Pit privy 10 Livestock pens 14 Abandoned water well  
 2 Sewer lines 5 Cess pool 8 Sewage lagoon 11 Fuel storage 15 Oil well/Gas well  
 3 Watertight sewer lines 6 Seepage pit 9 Feedyard 12 Fertilizer storage 16 Other (specify below)  
 13 Insecticide storage  
 Direction from well? East How many feet? 200

FROM	TO	LITHOLOGIC LOG	FROM	TO	LITHOLOGIC LOG
0	65	0' overburden			
65	80	08 med. sand			
80	100	med. sand + clay			
100	120	diffuse sand + clay			
120	150	01 Blue Clay			

7 CONTRACTOR'S OR LANDOWNER'S CERTIFICATION: This water well was (1) constructed, (2) reconstructed, or (3) plugged under my jurisdiction and was completed on (mo/day/year) 3/25/83 and this record is true to the best of my knowledge and belief. Kansas Water Well Contractor's License No. 142 This Water Well Record was completed on (mo/day/yr) 3/28/83 under the business name of T & W Water Well Service by (signature) M. E. Goyen

INSTRUCTIONS: Use typewriter or ball point pen, PLEASE PRESS FIRMLY and PRINT clearly. Please fill in blanks, underline or circle the correct answers. Send top three copies to Kansas Department of Health and Environment, Division of Environment, Environmental Geology Section, Topeka, KS 66620. Send one to WATER WELL OWNER and retain one for your records.

OFFICE USE ONLY  
 T 30  
 R 25  
 EW  
 SEC. 15  
 NW 1/4 SW 1/4

DP