


WATER WELL RECORD Form WWC-5 KSA 82A-1212

1 LOCATION OF WATER WELL: FRACTION SECTION NUMBER TOWNSHIP NUMBER RANGE NUMBER
 COUNTY: 060 MEADE NE 1/4 NW 1/4 SE 1/4 03 T 30 S R 26 W

DISTANCE AND DIRECTION FROM NEAREST TOWN OR CITY STREET ADDRESS OF WELL IF LOCATED WITHIN CITY?
 FROM FOWLER; 5 1/2 MILES NORTH & 3 MILES EAST

2 WATER WELL OWNER: MARIETTA PAGENKOPF
 RR#, St. Address, Box #: 2508 5TH AVE BOARD OF AGRICULTURE, DIVISION OF WATER RESOURCES
 CITY, STATE, ZIP CODE : DODGE CITY, KS 67801-2436 APPLICATION NUMBER: 20288

3 LOCATE WELL'S LOCATION WITH
 AN "X" IN SECTION BOX:

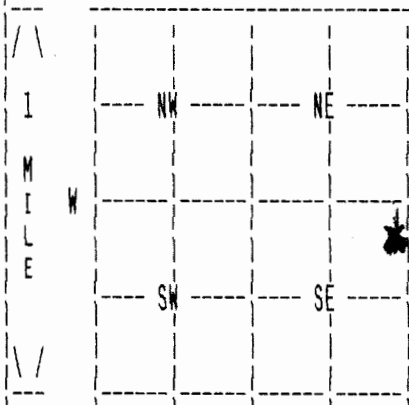

4 DEPTH OF COMPLETED WELL 288 ELEVATION: 0
 DEPTH(S) GROUNDWATER ENCOUNTERED 1. 0 FT. 2. 0 FT. 3. 0 FT.

WELL'S STATIC WATER LEVEL 120 FT. BELOW LAND SURFACE MEASURED ON MO/DAY/YR 08/25/03
 PUMP TEST DATA: WELL WATER WAS 200 FT. AFTER 4 HOURS PUMPING 496 GPM

ESTIMATED YIELD 0 GPM: WELL WATER WAS 0 FT. AFTER 0 HOURS PUMPING 0 GPM

BORE HOLE DIAMETER 24 IN. TO 288 FT., AND IN. TO 0 FT.

WELL WATER TO BE USED AS: 02 IRRIGATION

WAS A CHEMICAL/BACTERIOLOGICAL SAMPLE SUBMITTED TO DEPARTMENT? No ;
 IF YES, MO/DAY/YR SAMPLE WAS SUBMITTED WATER WELL DISINFECTED? Yes

5 TYPE OF BLANK CASING USED: 01 STEEL CASING JOINTS: WELDED
 BLANK CASING DIAMETER 16 IN. TO 288 FT., DIA IN. TO 0 FT., DIA IN. TO 0 FT.
 CASING HEIGHT ABOVE LAND SURFACE 12 IN., WEIGHT 42 LBS/FT. WALL THICKNESS OR GAUGE NO. .250
 TYPE OF SCREEN OR PERFORATION MATERIAL: 01 STEEL
 SCREEN OR PERFORATION OPENINGS ARE: 01 CONT. SLOT

SCREEN PERFORATED INTERVALS: FROM 155 FT. TO 215 FT., FROM 0 FT. TO 0 FT.
 FROM 238 FT. TO 268 FT., FROM 0 FT. TO 0 FT.
 GRAVEL PACK INTERVALS: FROM 20 FT. TO 288 FT., FROM 0 FT. TO 0 FT.
 FROM 0 FT. TO 0 FT., FROM 0 FT. TO 0 FT.

6 GROUT MATERIAL 03 BENTONITE
 GROUT INTERVALS: FROM 0 FT. TO 20 FT., FROM 0 FT. TO 0 FT., FROM 0 FT. TO 0 FT.
 WHAT IS THE NEAREST SOURCE OF POSSIBLE CONTAMINATION: 14 ABAND. WELL
 DIRECTION FROM WELL? NORTHWEST HOW MANY FEET? 50

FROM	TO	LITHOLOGIC LOG	FROM	TO	PLUGGING INTERVALS
0	1	02 SILT			
1	43	04 SANDY CLAY 31 CALICHE			
43	78	04 SANDY CLAY			
78	133	01 CLAY 05 SAND			
133	140	04 SANDY CLAY 05 SAND			
140	169	05 SAND 01 CLAY			
169	176	01 CLAY 05 SAND			
176	203	05 SAND 13 FINE GRAVEL 01 CLAY			
203	228	05 SAND 01 CLAY			
228	248	05 SAND 01 CLAY			

7 CONTRACTOR'S OR LANDOWNER'S CERTIFICATION: THIS WATER WELL WAS CONSTRUCTED UNDER MY JURISDICTION AND WAS
 COMPLETED ON (MO/DAY/YEAR) 08/22/03 AND THIS RECORD IS TRUE TO THE BEST OF MY KNOWLEDGE AND BELIEF. KANSAS
 WATER WELL CONTRACTOR'S LICENSE NO. 145 THIS WATER WELL RECORD WAS COMPLETED ON (MO/DAY/YR) 10/03/03
 UNDER THE BUSINESS NAME OF HENKLE DRILLING & SUPPLY BY (SIGNATURE)

(CONTINUED)

WATER WELL RECORD Form WWC-5 KSA 82A-1212

1 LOCATION OF WATER WELL:	FRACTION	SECTION NUMBER	TOWNSHIP NUMBER	RANGE NUMBER
COUNTY: 060 MEADE	NE 1/4 NW 1/4 SE 1/4	03	T 30 S	R 26 W

2 WATER WELL OWNER:	MARIETTA PAGENKOPF	
RR#, ST. ADDRESS, BOX # :	2508 5TH AVE	BOARD OF AGRICULTURE, DIVISION OF WATER RESOURCES
CITY, STATE, ZIP CODE :	DODGE CITY, KS 67801-2436	APPLICATION NUMBER: 20288

FROM	TO	LITHOLOGIC LOG
248	280	04 SANDY CLAY

7 CONTRACTOR'S OR LANDOWNER'S CERTIFICATION: THIS WATER WELL WAS CONSTRUCTED UNDER MY JURISDICTION AND WAS COMPLETED ON (MO/DAY/YEAR) 08/22/03 AND THIS RECORD IS TRUE TO THE BEST OF MY KNOWLEDGE AND BELIEF. KANSAS WATER WELL CONTRACTOR'S LICENSE NO. 145 THIS WATER WELL RECORD WAS COMPLETED ON (MO/DAY/YR) 10/03/03 UNDER THE BUSINESS NAME OF HENKLE DRILLING & SUPPLY BY (SIGNATURE) *Bruce Richman*