


WATER WELL RECORD Form WWC-5 KSA 82a-1212

1 LOCATION OF WATER WELL: Fraction Section Number Township Number Range Number
 COUNTY: 060 MEADE NE 1/4 NE 1/4 NW 1/4 31 T 30 S R 26 W

Distance and direction from nearest town or city street address of well if located within city?
 FROM MEADE; APPX 6 3/4 MILES NORTH & 6 MILES WEST

2 WATER WELL OWNER: TOM HUELSKAMP
 RR#, St. Address, Box # : RT 1 BOX 83 Board of Agriculture, Division of Water Resources
 City, State, ZIP code : FOWLER, KS 67844- Application Number: 3,627

3 LOCATE WELL'S LOCATION WITH AN "X" IN SECTION BOX:

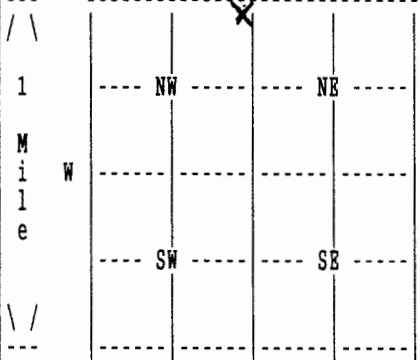

4 DEPTH OF COMPLETED WELL 285 ELEVATION: 0
 Depth(s) Groundwater Encountered 1. 0 ft. 2. 0 ft. 3. 0 ft.

WELL'S STATIC WATER LEVEL 46 ft. below land surface measured on mo/day/yr 05/17/06
 Pump test data: Well water was 235 ft. after 4 hours pumping 267 gpm

Estimated Yield 0 gpm: Well water was 0 ft. after 0 hours pumping 0 gpm

Bore Hole Diameter 24 in. to 485 ft., and in. to 0 ft.

WELL WATER TO BE USED AS: 02 IRRIGATION

Was a chemical/bacteriological sample submitted to department? No ;
 If yes, mo/day/yr sample was submitted Water well disinfected? Yes

5 TYPE OF BLANK CASING USED: 01 STEEL CASING JOINTS: WELDED
 Blank casing diameter 16 in. to 285 ft., Dia in. to 0 ft., Dia in. to 0 ft.
 Casing height above land surface 12 in., weight 42 lbs/ft. Wall thickness or gauge No. .250
 TYPE OF SCREEN OR PERFORATION MATERIAL: 01 STEEL
 SCREEN OR PERFORATION OPENINGS ARE: 01 CONT. SLOT

SCREEN PERFORATED INTERVALS: From 160 ft. to 280 ft., From 0 ft. to 0 ft.
 From 0 ft. to 0 ft., From 0 ft. to 0 ft.
 GRAVEL PACK INTERVALS: From 20 ft. to 285 ft., From 0 ft. to 0 ft.
 From 0 ft. to 0 ft., From 0 ft. to 0 ft.

6 GROUT MATERIAL 03 BENTONITE
 Grout Intervals: From 0 ft. to 20 ft., From 0 ft. to 0 ft., From 0 ft. to 0 ft.
 What is the nearest source of possible contamination: NONE OBSERVED
 Direction from well? How many feet? 0

FROM	TO	LITHOLOGIC LOG	FROM	TO	PLUGGING INTERVALS
0	2	02 SILT			
2	68	04 SANDY CLAY 05 SAND 01 CLAY			
68	146	01 CLAY			
146	156	07 FINE SAND 01 CLAY			
156	171	05 SAND			
171	175	04 SANDY CLAY			
175	193	05 SAND 04 SANDY CLAY			
193	197	01 CLAY			
197	233	07 FINE SAND 08 MEDIUM SAND 01 CLAY			
233	260	20 LIMESTONE			

7 CONTRACTOR'S OR LANDOWNER'S CERTIFICATION: This water well was Constructed under my jurisdiction and was completed on (mo/day/year) 05/16/06 and this record is true to the best of my knowledge and belief. Kansas Water Well Contractor's License No. 145 This Water Well Record was completed on (mo/day/yr) 06/23/06 under the business name of HENKLE DRILLING & SUPPLY by (signature)

(Continued)

WATER WELL RECORD Form WWC-5 KSA 82a-1212

1 LOCATION OF WATER WELL: COUNTY: 060 MEADE	Fraction NE 1/4 NE 1/4 NW 1/4	Section Number 31	Township Number T 30 S	Range Number R 26 W
--	----------------------------------	----------------------	---------------------------	------------------------

2 WATER WELL OWNER: TOM HUELSKAMP
RR#, St. Address, Box #: RT 1 BOX 83
City, State, ZIP code: FOWLER, KS 67844-
Board of Agriculture, Division of Water Resources
Application Number: 3,627

FROM	TO	LITHOLOGIC LOG
260	273	04 SANDY CLAY
273	280	28 ROCK 31 CALICHE
280	320	19 SHALE

7 CONTRACTOR'S OR LANDOWNER'S CERTIFICATION: This water well was Constructed under my jurisdiction and was completed on (mo/day/year) 05/16/06 and this record is true to the best of my knowledge and belief. Kansas Water Well Contractor's License No. 145 This Water Well Record was completed on (mo/day/yr) 06/23/06 under the business name of HENKLE DRILLING & SUPPLY by (signature) *Bruce J. Reichmuth*