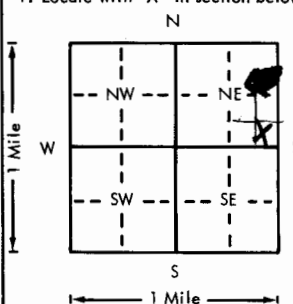


USE TYPEWRITER OR BALL
POINT PEN-PRESS FIRMLY,
PRINT CLEARLY.

WATER WELL RECORD
KSA 82a-1201-1215

Kansas Department of Health and
Environment-Division of Environment
(Water well Contractors)
Topeka, Kansas 66620

1. Location of well:		County MedDE	Fraction C 1/4 SE NE 1/4	Section number 24	Township number T 30 S	Range number R 26 E W
2. Distance and direction from nearest town or city: Street address of well location if in city:		3. Owner of well: R.R. or street: City, state, zip code:				
4. Locate with "X" in section below: 		Sketch map:		6. Bore hole dia. _____ in. Completion date _____ Well depth 160 ft. 8-24-81		
5. Type and color of material		From	To	7. Cable tool <input checked="" type="checkbox"/> Rotary _____ Driven _____ Dug _____ Hollow rod _____ Jetted _____ Bored _____ Reverse rotary _____		
CLAY		0	50	8. Use: _____ Domestic _____ Public supply _____ Industry _____ Irrigation _____ Air conditioning _____ Stock _____ Lawn _____ Oil field water _____ Other _____		
SAND + CLAY		50	90	9. Casing: Material PVC Height Above or below _____ Threaded _____ Welded _____ Surface 24 in. _____ RMP _____ PVC <input checked="" type="checkbox"/> Weight _____ lbs./ft. _____ Dia. 5 in. to 160 ft. depth Wall Thickness _____ inches or _____ Dia. _____ in. to _____ ft. depth Gauge No. SDR 21		
SAND some CLAY		90	120	10. Screen: Manufacturer's name _____ Type PVC Dia. 5 1/2 in. _____ Slot/gauze 125 Length 20' _____ Set between 140 ft. and 160 ft. _____ Gravel pack? <input checked="" type="checkbox"/> Size range of material 1/4 30% Fine		
DAKOTA SAND		120	160	11. Static water level: _____ mo./day/yr. _____ 120 ft. below land surface Date 8-26-81		
				12. Pumping level below land surfaces: _____ _____ ft. after _____ hrs. pumping _____ g.p.m. _____ _____ ft. after _____ hrs. pumping _____ g.p.m. _____ Estimated maximum yield 50 g.p.m. _____		
				13. Water sample submitted: _____ mo./day/yr. _____ Yes <input checked="" type="checkbox"/> No _____ Date _____		
				14. Well head completion: _____ Pitless adapter 24 inches above grade		
				15. Well cased? <input checked="" type="checkbox"/> Yes _____ With: <input checked="" type="checkbox"/> Neat cement _____ Bentonite _____ Concrete _____ Depth: From 0 ft. to 10 ft. _____		
				16. Nearest source of possible contamination: _____ ft. _____ Direction _____ Type N/A _____ Well disinfected upon completion? Yes _____ No _____		
				17. Pump: _____ Manufacturer's name _____ Not installed <input checked="" type="checkbox"/> Model number _____ HP _____ Volts _____ Length of drop pipe _____ ft. capacity _____ g.p.m. _____ Type: _____ Submersible _____ Turbine _____ _____ Jet _____ Reciprocating _____ _____ Centrifugal _____ Other _____		
18. Elevation:		19. Remarks:		20. Water well contractor's certification: This well was drilled under my jurisdiction and this report is true to the best of my knowledge and belief. BRAU DRILLING 217 Business name Bucklin Ks License No. _____ Address 7th Ave Date 8-26-81 Signed _____ Authorized representative		