


1 LOCATION OF WATER WELL: County: <b>MEADE</b>	Fraction <b>Near Center</b> $\frac{1}{4}$ $\frac{1}{4}$ <b>NW</b> $\frac{1}{4}$	Section Number <b>31</b>	Township Number <b>T 30 S</b>	Range Number <b>R 26 EW</b>
---	--	-----------------------------	----------------------------------	--------------------------------

Distance and direction from nearest town or city street address of well if located within city?  
**Approx. 3/4 mile north and 3/4 west of Fowler, KS**

2 WATER WELL OWNER: **Robert Young**  
 RR#, St. Address, Box # : **RFD** Board of Agriculture, Division of Water Resources  
 City, State, ZIP Code : **Fowler, KS 67844** Application Number: **19,629**

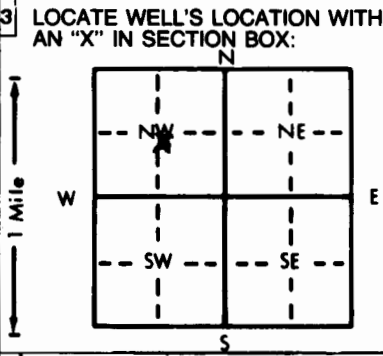

4 DEPTH OF COMPLETED WELL **.407'** ft. ELEVATION: ..... ft.

Depth(s) Groundwater Encountered 1. .... ft. 2. .... ft. 3. .... ft.

WELL'S STATIC WATER LEVEL **.92'** ft. below land surface measured on mo/day/yr .....

Pump test data: Well water was **.278** ft. after **4** hours pumping **.1387** gpm

Est. Yield **.1400** gpm: Well water was ..... ft. after ..... hours pumping ..... gpm

Bore Hole Diameter **.24"** in. to **.407'** ft., and ..... in. to ..... ft.

WELL WATER TO BE USED AS: 5 Public water supply 8 Air conditioning 11 Injection well  
 1 Domestic 3 Feedlot 6 Oil field water supply 9 Dewatering 12 Other (Specify below)  
2 Irrigation 4 Industrial 7 Lawn and garden only 10 Observation well .....

Was a chemical/bacteriological sample submitted to Department? Yes.....No **X**.....; If yes, mo/day/yr sample was submitted

Water Well Disinfected? Yes No **X**

5 TYPE OF BLANK CASING USED: 5 Wrought iron 8 Concrete tile CASING JOINTS: Glued ..... Clamped .....  
 1 Steel 3 RMP (SR) 6 Asbestos-Cement 9 Other (specify below) Welded .....  
 2 PVC 4 ABS 7 Fiberglass ..... Threaded.....

Blank casing diameter **.16"** in. to **.407'** ft., Dia ..... in. to ..... ft., Dia ..... in. to ..... ft.

Casing height above land surface **.12"** in., weight **42.05** lbs./ft. Wall thickness or gauge No. **.250"**

TYPE OF SCREEN OR PERFORATION MATERIAL: 7 PVC 10 Asbestos-cement  
 1 Steel 3 Stainless steel 5 Fiberglass 8 RMP (SR) 11 Other (specify) .....  
 2 Brass 4 Galvanized steel 6 Concrete tile 9 ABS 12 None used (open hole)

SCREEN OR PERFORATION OPENINGS ARE: 5 Gauzed wrapped 8 Saw cut 11 None (open hole)  
 1 Continuous slot 3 Mill slot 6 Wire wrapped 9 Drilled holes  
 2 Louvered shutter 4 Key punched 7 Torch cut 10 Other (specify) .....

SCREEN-PERFORATED INTERVALS: From **.267-407'** ft. to ..... ft., From ..... ft. to ..... ft.  
 From ..... ft. to ..... ft., From ..... ft. to ..... ft.

GRAVEL PACK INTERVALS: From **20-407'** ft. to ..... ft., From ..... ft. to ..... ft.  
 From ..... ft. to ..... ft., From ..... ft. to ..... ft.

6 GROUT MATERIAL: 1 Neat cement 2 Cement grout 3 Bentonite 4 Other .....

Grout Intervals: From **0** ft. to **20'** ft., From ..... ft. to ..... ft., From ..... ft. to ..... ft.

What is the nearest source of possible contamination: 10 Livestock pens 14 Abandoned water well  
 1 Septic tank 4 Lateral lines 7 Pit privy 11 Fuel storage 15 Oil well/Gas well  
 2 Sewer lines 5 Cess pool 8 Sewage lagoon 12 Fertilizer storage 16 Other (specify below)  
 3 Watertight sewer lines 6 Seepage pit 9 Feedyard 13 Insecticide storage .....

Direction from well? How many feet? **NONE OBSERVED**

FROM	TO	LITHOLOGIC LOG	FROM	TO	LITHOLOGIC LOG
		<b>SEE ATTACHED LOG</b>			

7 CONTRACTOR'S OR LANDOWNER'S CERTIFICATION: This water well was (1) constructed, (2) reconstructed, or (3) plugged under my jurisdiction and was completed on (mo/day/year) **8-18-87** ..... and this record is true to the best of my knowledge and belief. Kansas Water Well Contractor's License No. **145** ..... This Water Well Record was completed on (mo/day/yr) **8-26-87** ..... under the business name of **Henkle Drilling & Supply CO., Inc.** by (signature) *Bruce J. Reichmuth*

