


1 LOCATION OF WATER WELL: County: Meade Fraction NW 1/4 NW 1/4 SW 1/4 Section Number 31 Township Number T 30 S Range Number R 26 EW

Distance and direction from nearest town or city street address of well if located within city? From north end of Fowler - 1675' North & 4780' West.

2 WATER WELL OWNER: Kenneth L. Walker RR#, St. Address, Box #: R R 1, Box 59 City, State, ZIP Code: Fowler, Kansas 67844 Board of Agriculture, Division of Water Resources Application Number: 40,436

3 LOCATE WELL'S LOCATION WITH AN "X" IN SECTION BOX:

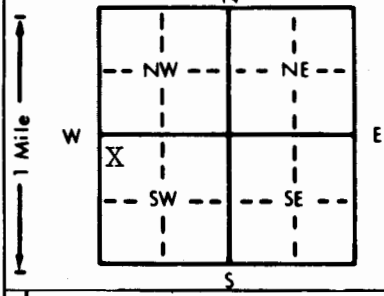

4 DEPTH OF COMPLETED WELL: 300 ft. ELEVATION: ... Depth(s) Groundwater Encountered ... WELL'S STATIC WATER LEVEL: 32 ft. below land surface measured on mo/day/yr 5-10-92

5 TYPE OF BLANK CASING USED: 1 Steel, 2 PVC, 3 RMP (SR), 4 ABS, 5 Wrought iron, 6 Asbestos-Cement, 7 Fiberglass, 8 Concrete tile, 9 Other (specify below) CASING JOINTS: Glued, Clamped, Welded, Threaded

6 GROUT MATERIAL: 1 Neat cement, 2 Cement grout, 3 Bentonite, 4 Other Grout Intervals: From 0 ft. to 20 ft. What is the nearest source of possible contamination: 1 Septic tank, 2 Sewer lines, 3 Watertight sewer lines, 4 Lateral lines, 5 Cess pool, 6 Seepage pit, 7 Pit privy, 8 Sewage lagoon, 9 Feedyard, 10 Livestock pens, 11 Fuel storage, 12 Fertilizer storage, 13 Insecticide storage, 14 Abandoned water well, 15 Oil well/Gas well, 16 Other (specify below)

Table with columns: FROM, TO, LITHOLOGIC LOG, FROM, TO, PLUGGING INTERVALS. Content: See attached log

7 CONTRACTOR'S OR LANDOWNER'S CERTIFICATION: This water well was (1) constructed, (2) reconstructed, or (3) plugged under my jurisdiction and was completed on (mo/day/year) 5-10-92 and this record is true to the best of my knowledge and belief. Kansas Water Well Contractor's License No. 208 This Water Well Record was completed on (mo/day/yr) 6-2-92 under the business name of Minter-Wilson Drilling Co., Inc. by (signature) Nora Keller