

USE TYPEWRITER OR BALL POINT PEN-PRESS FIRMLY, PRINT CLEARLY.


WATER WELL RECORD  
KSA 82a-1201-1215

Kansas Department of Health and Environment-Division of Environment  
(Water well Contractors)  
Topeka, Kansas 66620

B B D Fowler

Location of well: County Meade Fraction NW NW SE Section number 27 Township number T 30 Range number S R 26 E/W

Distance and direction from nearest town or city: ~~2 1/2 mi E~~ Street address of well location if in city: 2E-1N of Fowler 3. Owner of well: Stanley Post R.R. or street: Fowler Mo City, state, zip code: 67844

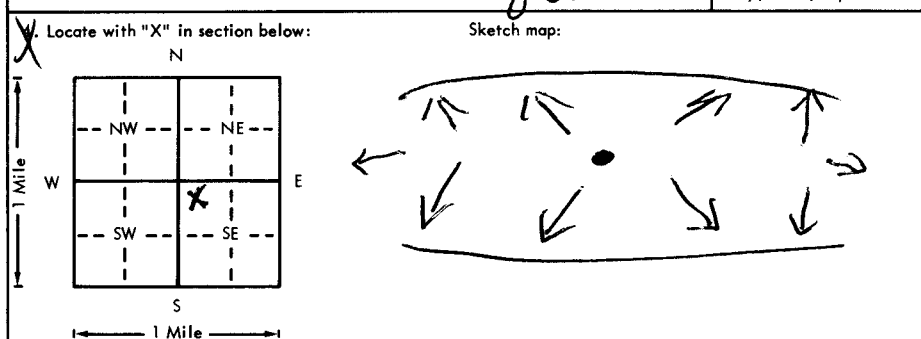

6. Bore hole dia. 8 3/4 in. Completion date 3-31-77  
Well depth 210 ft.  
7.  Cable tool  Rotary  Driven  Dug  
 Hollow rod  Jetted  Bored  Reverse rotary  
8. Use:  Domestic  Public supply  Industry  
 Irrigation  Air conditioning  Stock  
 Lawn  Oil field water  Other  
9. Casing: Material plastic Height: Above or below  
Threaded  Welded  Surface 24 in.  
RMP  PVC  Weight  lbs./ft.  
Dia. 5 in. to 210 ft. depth Wall Thickness: inches or  
Dia.  in. to  ft. depth gage No. 320 well

5. Type and color of material	From	To
Top Soil	0	4
Sand	4	60
Clay	60	130
Gravel	130	140
Clay	140	158
Gravel	158	160
Clay	160	195
Gravel	195	210
(Use a second sheet if needed)		

10. Screen: Manufacturer's name Sunflower Plastics  
Type PVC Dia. 5  
Slot/gauze 1/16 Length   
Set between 150 ft. and 210 ft.  
 ft. and  ft.  
Gravel pack?  Size range of material 1/16-1/4  
11. Static water level:  mo./day/yr.  
60 ft. below land surface Date 3/29/77  
12. Pumping level below land surfaces:  
142 ft. after 1 hrs. pumping 20 g.p.m.  
 ft. after  hrs. pumping  g.p.m.  
Estimated maximum yield 35 g.p.m.  
13. Water sample submitted:  mo./day/yr.  
 Yes  No Date 3-31-77  
14. Well head completion:  
 Pitless adapter  Inches above grade  
 Well grouted?   
With:  Neat cement  Bentonite  Concrete  
Depth: From 210 ft. to 210 ft. 0-10  
16. Nearest source of possible contamination:  
ft. 2500 Direction West Type farm cesspool  
Well disinfected upon completion?  Yes  No  
17. Pump:  Not installed  
Manufacturer's name   
Model number  HP  Volts   
Length of drop pipe  ft. capacity  g.p.m.  
Type: Windmill  
 Submersible  Turbine  
 Jet  Reciprocating  
 Centrifugal  Other

18. Elevation:  
Topography:  
 Hill  
 Slope  
 Upland  
 Valley

19. Remarks:  
Too much relief

20. Water well contractor's certification:  
This well was drilled under my jurisdiction and this report is true to the best of my knowledge and belief.  
Bertil Ditz 101 A  
Business name meade Mo License No.   
Address Fowler Mo  
Signed Peter Bertil Date 3-31-77  
Authorized representative

T 30 R 26 E S 27 NW 1/4 SE

Forward the white, blue and pink copies to the Department of Health and Environment

Form WWC-5