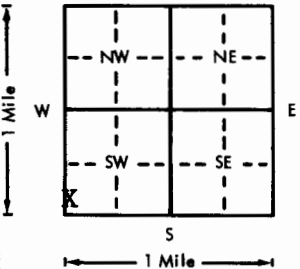


USE TYPEWRITER OR BALL POINT PEN—PRESS FIRMLY, PRINT CLEARLY.

WATER WELL RECORD
KSA 82a-1201-1215

Kansas Department of Health and Environment—Division of Environment
(Water well Contractors)
Topeka, Kansas 66620

1. Location of well:		County Meade	Fraction SW 1/4 SW 1/4 SW 1/4	Section number 29	Township number T 30 S R 26	Range number 26	W
2. Distance and direction from nearest town or city: Street address of well location if in city: 1 m north Fowler				3. Owner of well: Don Hildebrand R.R. or street: Fowler, Kansas 67844 City, state, zip code:			
4. Locate with "X" in section below: N 			Sketch map:			6. Bore hole dia. 9 7/8 in. Completion date _____ Well depth 175 ft. 6-29-76	
5. Type and color of material			From	To	7. <input type="checkbox"/> Cable tool <input checked="" type="checkbox"/> Rotary <input type="checkbox"/> Driven <input type="checkbox"/> Dug <input type="checkbox"/> Hollow rod <input type="checkbox"/> Jetted <input type="checkbox"/> Bored <input type="checkbox"/> Reverse rotary		
Top soil			0	5	8. Use: <input checked="" type="checkbox"/> Domestic <input type="checkbox"/> Public supply <input type="checkbox"/> Industry <input type="checkbox"/> Irrigation <input type="checkbox"/> Air conditioning <input type="checkbox"/> Stock <input type="checkbox"/> Lawn <input type="checkbox"/> Oil field water <input type="checkbox"/> Other		
Clay			6	35	9. Casing: Material PVC Height: ASXX or below Threaded _____ Welded <input checked="" type="checkbox"/> Surface 12 in. RMP _____ PVC _____ Weight _____ lbs./ft. Dia. 5 in. to 175 ft. depth Wall Thickness: inches or Dia. _____ in. to _____ ft. depth gage No. .265		
Fine sand			36	42	10. Screen: Manufacturer's name Jess & Lowell Type PVC Dia. 5" Slot/gauze 1/8" Length 40' Set between 135 ft. and 175 ft. _____ ft. and _____ ft.		
Sandy clay			43	80	11. Static water level: _____ mo./day/yr. 22 ft. below land surface Date 6/16/76		
Med. to lar. sand			81	95	12. Pumping level below land surfaces: _____ ft. after _____ hrs. pumping _____ g.p.m. _____ ft. after _____ hrs. pumping _____ g.p.m. Estimated maximum yield _____ g.p.m.		
Clay with gravel streaks			96	175	13. Water sample submitted: _____ mo./day/yr. Yes <input type="checkbox"/> No <input checked="" type="checkbox"/> Date _____		
_____					14. Well head completion: <input checked="" type="checkbox"/> Pitless adapter 12 inches above grade		
_____					15. Well grouted? yes With: _____ Neat cement _____ Bentonite <input checked="" type="checkbox"/> Concrete Depth: From 4 ft. to 14 ft.		
_____					16. Nearest source of possible contamination: ft. 6 Direction east Type old well Well disinfected upon completion? <input checked="" type="checkbox"/> Yes _____ No		
_____					17. Pump: _____ Not installed Manufacturer's name Aermotor Model number SD19 HP 1 Volts 220 Length of drop pipe 100 ft. capacity 20 g.p.m. Type: <input checked="" type="checkbox"/> Submersible _____ Turbine <input type="checkbox"/> Jet _____ Reciprocating <input type="checkbox"/> Centrifugal _____ Other		
(Use a second sheet if needed)					20. Water well contractor's certification: This well was drilled under my jurisdiction and this report is true to the best of my knowledge and belief. Friesen Windmill 252 Business name License No. Address Meade Kansas 67864 Signed <i>Jah... 1-76</i> Date 7-1-76 Authorized representative		
18. Elevation:		19. Remarks:		20. Water well contractor's certification:			
Topography: <input type="checkbox"/> Hill <input type="checkbox"/> Slope <input checked="" type="checkbox"/> Upland <input type="checkbox"/> Valley							

30 26 29
 Sec
 1/4 1/4 1/4

Forward the white, blue and pink copies to the Department of Health and Environment

Form WWC-5