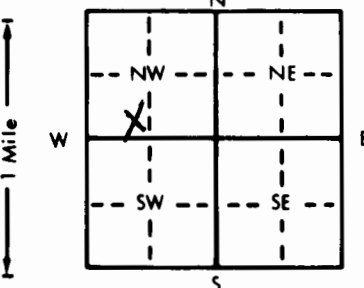


1 LOCATION OF WATER WELL: Fraction SE 1/4 SW 1/4 NW 1/4 Section Number 30 Township Number T 3 S Range Number R 26 EW

Distance and direction from nearest town or city street address of well if located within city?  
1.25 N 0.5 W OF FOWLER

2 WATER WELL OWNER: LEVINE FRICKE  
RR#, St. Address, Box # : 401 WASHINGTON STREET Board of Agriculture, Division of Water Resources  
City, State, ZIP Code : ALGONQUIN, IL 60102 Application Number:

3 LOCATE WELL'S LOCATION WITH AN "X" IN SECTION BOX:  


4 DEPTH OF COMPLETED WELL 23 ft. ELEVATION:  
 Depth(s) Groundwater Encountered 1. 15 ft. 2. ft. 3. ft.  
 WELL'S STATIC WATER LEVEL 15 ft. below land surface measured on mo/day/yr 2-19-95  
 Pump test data: Well water was N/A ft. after hours pumping gpm  
 Est. Yield 2-5 gpm: Well water was ft. after hours pumping gpm  
 Bore Hole Diameter 8 in. to 23.5 ft., and in. to ft.  
 WELL WATER TO BE USED AS:  
 5 Public water supply 8 Air conditioning 11 Injection well  
 1 Domestic 3 Feedlot 6 Oil field water supply 9 Dewatering 12 Other (Specify below)  
 2 Irrigation 4 Industrial 7 Lawn and garden only 10 Monitoring well  
 Was a chemical/bacteriological sample submitted to Department? Yes No X; If yes, mo/day/yr sample was submitted  
 Water Well Disinfected? Yes No X

5 TYPE OF BLANK CASING USED:  
 1 Steel 3 RMP (SR) 5 Wrought iron 8 Concrete tile CASING JOINTS: Glued Clamped  
 2 PVC 4 ABS 6 Asbestos-Cement 9 Other (specify below) Welded  
 7 Fiberglass Threaded  
 Blank casing diameter 2 in. to 13 ft., Dia in. to ft., Dia in. to ft.  
 Casing height above land surface 36 in., weight lbs./ft. Wall thickness or gauge No. SCHEDULE 40  
 TYPE OF SCREEN OR PERFORATION MATERIAL:  
 1 Steel 3 Stainless steel 5 Fiberglass 8 RMP (SR) 10 Asbestos-cement 11 Other (specify)  
 2 Brass 4 Galvanized steel 6 Concrete tile 9 ABS 12 None used (open hole)  
 SCREEN OR PERFORATION OPENINGS ARE:  
 1 Continuous slot 3 Mill slot 5 Gauzed wrapped 8 Saw cut 11 None (open hole)  
 2 Louvered shutter 4 Key punched 6 Wire wrapped 9 Drilled holes  
 7 Torch cut 10 Other (specify)  
 SCREEN-PERFORATED INTERVALS: From 13 ft. to 23 ft., From ft. to ft.  
 From 11 ft. to 23 ft., From ft. to ft.  
 GRAVEL PACK INTERVALS: From ft. to ft., From ft. to ft.  
 From ft. to ft., From ft. to ft.

6 GROUT MATERIAL: 1 Neat cement 2 Cement grout 3 Bentonite 4 Other  
 Grout Intervals: From 0 ft. to 8 ft., From ft. to ft., From 8 ft. to 11 ft.  
 What is the nearest source of possible contamination:  
 1 Septic tank 4 Lateral lines 7 Pit privy 10 Livestock pens 14 Abandoned water well  
 2 Sewer lines 5 Cess pool 8 Sewage lagoon 11 Fuel storage 15 Oil well/Gas well  
 3 Watertight sewer lines 6 Seepage pit 9 Feedyard 12 Fertilizer storage 16 Other (specify below)  
 UNKNOWN  
 Direction from well? How many feet? 1000

FROM	TO	LITHOLOGIC LOG	FROM	TO	PLUGGING INTERVALS
0	13	BROWNISH CLAY			
13	14	LIGHT GRAY SILT, BROWNISH YELLOW SILTY SAND			
14	21	YELLOWISH BROWN SAND			
21	23	BROWNISH GRAY SANDY SILT			

7 CONTRACTOR'S OR LANDOWNER'S CERTIFICATION: This water well was (1) constructed, (2) reconstructed, or (3) plugged under my jurisdiction and was completed on (mo/day/year) 2/19/95 and this record is true to the best of my knowledge and belief. Kansas Water Well Contractor's License No. 438 This Water Well Record was completed on (mo/day/yr) 3/16/95 under the business name of Huntington Eng + Env by (signature) William J. Purdon