


1 LOCATION OF WATER WELL: Fraction NE 1/4 NE 1/4 SW 1/4 Section Number 27 Township Number T 30 S R 27 E County: Mend

Distance and direction from nearest town or city street address of well if located within city?  
Go N. of Fowler 2 miles then 3 miles west and 1/2 mile south

2 WATER WELL OWNER: Fowler Feeders Monitor Well  
 RR#, St. Address, Box #: 5113 23 Rd. Rd. #4 Board of Agriculture, Division of Water Resources  
 City, State, ZIP Code: Fowler KS 67844 Application Number:

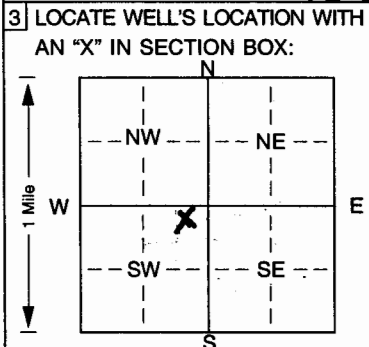

4 DEPTH OF COMPLETED WELL: 62 ft. ELEVATION:  
 Depth(s) Groundwater Encountered 1. 42 ft. 2. ft. 3. ft.  
 WELL'S STATIC WATER LEVEL 28.4 ft. below land surface measured on mo/day/yr 4-19-02  
 Pump test data: Well water was ft. after hours pumping gpm  
 Est. Yield gpm: Well water was ft. after hours pumping gpm  
 Bore Hole Diameter: 8 1/4 in. to 62 ft. and in. to ft.  
 WELL WATER TO BE USED AS:  
 5 Public water supply 8 Air conditioning 11 Injection well  
 1 Domestic 3 Feedlot 6 Oil field water supply 9 Dewatering 12 Other (Specify below)  
 2 Irrigation 4 Industrial 7 Domestic (lawn & garden) 10 Monitoring well  
 Was a chemical/bacteriological sample submitted to Department? Yes. No. X; If yes, mo/day/yr sample was submitted  
 Water Well Disinfected? Yes No X

5 TYPE OF BLANK CASING USED:  
 1 Steel 3 RMP (SR) 5 Wrought iron 8 Concrete tile CASING JOINTS: Glued. Clamped.  
2 PVC 4 ABS 6 Asbestos-Cement 9 Other (specify below) Welded.  
 7 Fiberglass Threaded. X

Blank casing diameter 2 in. to 35 ft., Dia. in. to ft., Dia. in. to ft.  
 Casing height above land surface 36 in., weight lbs./ft. Wall thickness or gauge No. Sch 40

TYPE OF SCREEN OR PERFORATION MATERIAL:  
 1 Steel 3 Stainless steel 5 Fiberglass 7 PVC 10 Asbestos-cement  
 2 Brass 4 Galvanized steel 6 Concrete tile 8 RMP (SR) 11 Other (specify)  
 9 ABS 12 None used (open hole)

SCREEN OR PERFORATION OPENINGS ARE:  
 1 Continuous slot 3 Mill slot -010 5 Gauzed wrapped 8 Saw cut 11 None (open hole)  
 2 Louvered shutter 4 Key punched 6 Wire wrapped 9 Drilled holes  
 7 Torch cut 10 Other (specify) ft.

SCREEN-PERFORATED INTERVALS: From 62 ft. to 37 ft., From ft. to ft.  
 From ft. to ft., From ft. to ft.  
 GRAVEL PACK INTERVALS: From 62 ft. to 35 ft., From ft. to ft.  
 From ft. to ft., From ft. to ft.

6 GROUT MATERIAL: 1 Neat cement 2 Cement grout 3 Bentonite 4 Other  
 Grout Intervals: From 35 ft. to 0 ft., From ft. to ft., From ft. to ft.

What is the nearest source of possible contamination:  
 1 Septic tank 4 Lateral lines 7 Pit privy 10 Livestock pens 14 Abandoned water well  
 2 Sewer lines 5 Cess pool 8 Sewage lagoon 11 Fuel storage 15 Oil well/Gas well  
 3 Watertight sewer lines 6 Seepage pit 9 Feedyard 12 Fertilizer storage 16 Other (specify below)  
 13 Insecticide storage  
 Direction from well? 999 How many feet? 999

FROM	TO	LITHOLOGIC LOG	FROM	TO	PLUGGING INTERVALS
<u>0</u>	<u>8</u>	<u>TOP SOIL MIXED W/ BROWN SILT</u>			
<u>8</u>	<u>15</u>	<u>BROWN CLAY MIXED W/ SILT</u>			
<u>15</u>	<u>37</u>	<u>TAN CLAY STIFF</u>			
<u>37</u>	<u>55</u>	<u>LT. GRAY MIXED W/ GREEN STREAKS OF CLAY</u>			
<u>55</u>	<u>62</u>	<u>RED CLAY MIXED W/ TAN CLAY</u>			

7 CONTRACTOR'S OR LANDOWNER'S CERTIFICATION: This water well was (1) constructed, (2) reconstructed, or (3) plugged under my jurisdiction and was completed on (mo/day/year) 4-19-02 and this record is true to the best of my knowledge and belief. Kansas Water Well Contractor's Licence No. 665 This Water Well Record was completed on (mo/day/yr) 4-25-02 under the business name of PRATT WELL ENVIRONMENTAL by (signature) Steven Egan