


1 LOCATION OF WATER WELL: Fraction (dr) NW NW SW Section Number Township Number Range Number
 County: Meade SW SW SW 36 30 S 27 W

Distance and direction from nearest town or city street address of well if located within city?
1 Mile West of Fowler

2 WATER WELL OWNER: Leroy Huelskamp
 RR #, St. Address, Box #: 3085 22 Rd.
 City, State, ZIP Code : Fowler KS 67844
 Board of Agriculture, Division of Water Resources
 Application Number: _____

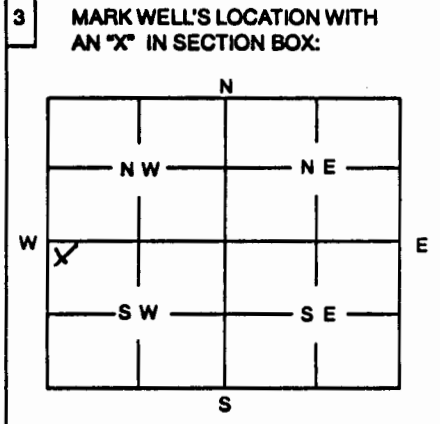

4 DEPTH OF WELL 200 ft
 WELL'S STATIC WATER LEVEL 30 ft.
 WELL WAS USED AS:
 1 Domestic 5 Public Water Supply 9 Dewatering
2 Irrigation 6 Oil Field Water Supply 10 Monitoring Well
 3 Feedlot 7 Domestic (Lawn & Garden) 11 Injection Well
 4 Industrial 8 Air Conditioning 12 Other

Was a chemical / bacteriological sample submitted to Department? Yes No X
 If yes, mo/day/yr sample was submitted

Water Well Disinfected: Yes X No

5 TYPE OF BLANK CASING USED:
1 Steel 3 RMP (SR) 5 Wrought 7 Fiberglass 9 Other (Specify below)
 2 PVC 4 ABS 6 Asbestos-Cement 8 Concrete Tile

Blank casing diameter 16 in. Was casing pulled? Yes No X If yes, how much

Casing height above or below land surface 60 in.

6 GROUT PLUG MATERIAL: 1 Neat cement 2 Cement grout 3 Bentonite 4 Other

Grout Plug Intervals: From ft. to ft., From ft. to ft., From to ft.

What is the nearest source of possible contamination:
 1 Septic tank 6 Seepage pit 11 Fuel storage 16 Other (specify below)
 2 Sewer lines 7 Pit privy 12 Fertilizer storage Irrigation Well
 3 Watertight sewer lines 8 Sewage lagoon 13 Insecticide storage
 4 Lateral lines 9 Feedyard 14 Abandoned water well
 5 Cess Pool 10 Livestock pens 15 Oil well/Gas well

Direction from well? Southeast How many feet? 1,000

FROM	TO	PLUGGING MATERIALS
<u>200</u>	<u>30</u>	<u>Chlorinated Sand</u>
<u>30</u>	<u>10</u>	<u>Clay / Subsoil</u>
<u>10</u>	<u>5</u>	<u>Cement</u>
<u>5</u>	<u>-</u>	<u>Cut-off Casing & Backfill</u>

RECEIVED
 OCT 28 2004
 BUREAU OF WATER

7 CONTRACTOR'S OR LANDOWNER'S CERTIFICATION: This water well was plugged under my jurisdiction and was completed on (mo/day/year) 10-19-04 and this record is true to the best of my knowledge and belief. Kansas Water Well Contractor's License No. This Water Well Record was completed on (mo/day/year) 10-20-04 under the business name of Southeast Winmill by (signature) David E.