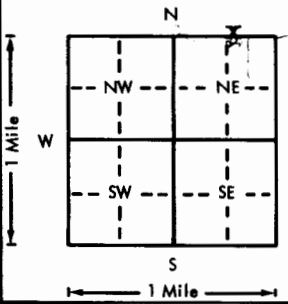


USE TYPEWRITER OR BALL
POINT PEN-PRESS FIRMLY-
PRINT CLEARLY.

WATER WELL RECORD
KSA 82a-1201-1215

Kansas Department of Health and
Environment-Division of Environment
(Water well Contractors)
Topeka, Kansas 66620

1. Location of well:		County Meade	Fraction NW 1/4 NE 1/4 NE 1/4	Section number 15	Township number T 30 S R 27 E/W	Range number
2. Distance and direction from nearest town or city: 4 mi north and 3 mi west of Fowler Street address of well location if in city:				3. Owner of well: G.E. Lundeen R.R. or street: RFD City, state, zip code: Fowler, Kansas		
4. Locate with "X" in section below: 				Sketch map:		
5. Type and color of material				From	To	
Surface				0	2	
Clay				2	31	
Clay and caliche				31	104	
hard stringers				104	111	
Clay				111	155	
fine sand				155	158	
Clay				158	161	
Fine sand				161	170	
Med. sand and gravel				170	190	
Clay				190	202	
Fine sand and clay layers				202	215	
Med. sand and gravel				215	255	
Sand rock				255	261	
Sand and gravel				261	335	
Clay				335	338	
Med. fine sand				338	356	
Caliche and clay				356	372	
Shale				372	376	
(Use a second sheet if needed)						
18. Elevation:		19. Remarks: Drilled for Johnson Drilling Co. They will install the grouting and base J O Johnson				20. Water well contractor's certification: This well was drilled under my jurisdiction and this report is true to the best of my knowledge and belief. Ace-Hi International 190 Business name Dodge City, Kansas License No. Address Signed G. E. Fittell Date 2-25-76 Authorized representative

Forward the white, blue and pink copies to the Department of Health and Environment

Form WWC-5