

USE TYPEWRITER OR BALL POINT PEN-PRESS FIRMLY, PRINT CLEARLY.

T R EW sec 1/4 1/4 1/4 No.


WATER WELL RECORD  
KSA 82a-1201-1215

Kansas State Dept. Of Health  
(Water Well Contractors)  
Forbes-Bldg. 740  
Topeka, Kansas 66620

1 Location of well:	County <b>Meade</b>	Township name <b>Crooked Creek NE 1/4 of NE 1/4</b>	Fraction	Section number <b>29</b>	Town number <b>T30-S</b>	Range number <b>R-27-W</b>
---------------------	------------------------	--	----------	-----------------------------	-----------------------------	-------------------------------

Distance and direction from nearest town or city:  
**5 mi west and 2 north of Fowler, Ks**  
Street address of well location if in city:

3 Owner of well:  
**Ronald Lewis Fowler, Kansas**  
Address:

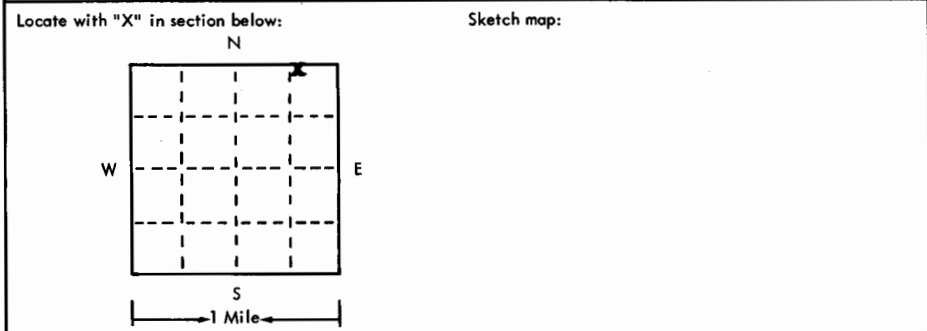

4 Well depth: 292 ft. Date of completion 6-20-75  
Well diameter 28 in.

5  Cable tool  Rotary  Driven  Dug  
 Hollow rod  Jetted  Bored  Reverse rotary

6 Use:  Domestic  Public supply  Industry  
 Irrigation  Air conditioning  Commercial  
 Test well

7 Casing: Material Meta Height: above/below  
Threaded  Welded  Surface 40 in. Remarks  
Diam. 16 in. Weight 16 lbs./ft.  
16 in. to 292 ft. depth! Drive shoe?  Yes  No  
\_\_\_ in. to \_\_\_ ft. depth!

2	Type and color of material	From	To
	Surface	0	3
	Brown clay	3	30
	Green clay	30	46
	Soft blue clay	46	85
	Brown and green clay	85	105
	<del>Fine sand with 10% clay mixed</del>	<del>105</del>	<del>116</del>
	Sandy brown clay	116	140
	Fine sand	140	148
	Caleche clay	148	163
	A-1 sand and gravel	163	210
	Clay	210	212
	A-1 sand and gravel	212	222
	Med. sand with 30% clay mixed	222	227
	Fine to 1/2 med. sand	227	257
	<del>A-1 sand and gravel</del>	<del>257</del>	<del>269</del>
	<del>Brown caleche clay</del>	<del>269</del>	<del>285</del>
	Good sand and gravel	285	291
	Caleche brown clay (use a second sheet if needed)	291	315

8 Screen: W.A. Brown Free-flo  
Manufacturer 10% Dia. 16  
Type 1 1/8 Length 2"  
Slot/gauze 1 1/2 ft. and 292 ft.  
Set between 70% #1 blend - 30% 3/8 down  
Fittings: 70% #1 blend - 30% 3/8 down  
Gravel pack  Yes  No Size range of material \_\_\_

9 Static water level: 35 ft. below land surface Date 6-18-75

10 Pumping level below land surfaces:  
116 ft. after 1 hrs. pumping 1080 g.p.m.  
135 ft. after 1 hrs. pumping 1600 g.p.m.  
Estimated maximum yield 2000 g.p.m.

11 Water sample submitted:  
 Yes  No Date \_\_\_

12 Well head completion:  
 Pitless adapter  Inches above grade

13 Well grouted?  Yes  No  
 Neat cement  Bentonite   
Depth: From 0 ft. to 10 ft.

14 Nearest source of possible contamination: Septic  
ft. 300! Direction West Type \_\_\_  
Well disinfected upon completion?  Yes  No

15 Pump:  Not installed  
Manufacturer's name Simmons ?  
Model number 3 stage 50 gear drive  
Length of drop pipe 170 ft. capacity \_\_\_ g.p.m.  
Type: Their used pump  
 Submersible  Turbine  
 Jet  Reciprocating  
 Centrifugal  Other

16 Remarks: elevation  
.188 wall plain - 31.66 weight per ft.  
.179 perf. 30.30 weight per ft/  
Topography:  
 Hill  
 Slope  
 Upland  
 Valley

17 Water well contractor's certification:  
This well was drilled under my jurisdiction and this report is true to the best of my knowledge and belief.  
**Ace-Hi Drilling Co 190**  
Business name License No. \_\_\_  
Address Box 1442, Dodge City, Ks  
Signed Carl C. Jital Date 6-30-75  
Authorized representative