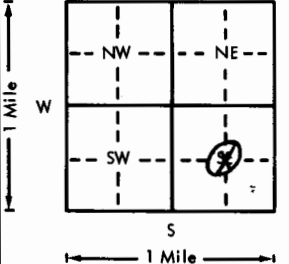
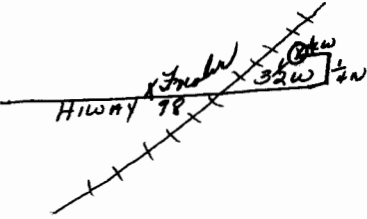


USE TYPEWRITER OR BALL POINT PEN-PRESS FIRMLY, PRINT CLEARLY.

WATER WELL RECORD  
KSA 82a-1201-1215

Kansas Department of Health and Environment-Division of Environment (Water well Contractors) Topeka, Kansas 66620

1. Location of well:	County <b>Meade</b>	Fraction <b>Center</b> 1/4 1/4 SE 1/4	Section number <b>34</b>	Township number T <b>30</b> S	Range number R <b>27</b> E <b>10</b>
2. Distance and direction from nearest town or city: <b>Fowler, north, west. 3 1/2 West of</b>			3. Owner of well: <b>L. M. Copenhaver</b> R.R. or street: <b>R. R. #2</b> City, state, zip code: <b>Fowler, Kansas 67844</b>		
4. Locate with "X" in section below: 			Sketch map: 		
5. Type and color of material			From	To	6. Bore hole dia. <u>9</u> in. Completion date <u>2-4-77</u> Well depth <u>280</u> ft.
<b>Surface</b>			0	2	7. <input checked="" type="checkbox"/> Cable tool <input checked="" type="checkbox"/> Rotary <input type="checkbox"/> Driven <input type="checkbox"/> Dug <input type="checkbox"/> Hollow rod <input type="checkbox"/> Jetted <input type="checkbox"/> Bored <input type="checkbox"/> Reverse rotary
<b>Blue Clay</b>			2	160	8. Use: <input checked="" type="checkbox"/> Domestic <input type="checkbox"/> Public supply <input type="checkbox"/> Industry <input type="checkbox"/> Irrigation <input type="checkbox"/> Air conditioning <input type="checkbox"/> Stock <input type="checkbox"/> Lawn <input type="checkbox"/> Oil field water <input type="checkbox"/> Other
<b>Clay</b>			160	180	9. Casing: Material _____ Height: Above or below Threaded _____ Welded _____ Surface <u>28</u> in. RMP _____ PVC <input checked="" type="checkbox"/> Weight <u>2.78</u> lbs./ft. Dia. <u>5</u> in. to <u>215</u> ft. depth Wall Thickness: inches or Dia. <u>5</u> in. to <u>280</u> ft. depth gage No. <u>265</u>
<b>Clay, fine sand &amp; Med. to Large sand</b>			180	220	10. Screen: Manufacturer's name _____ <b>sawed</b> Type <u>PVC</u> Dia. <u>5"</u> Slot/gauze _____ Length <u>60</u> Set between <u>215</u> ft. and <u>275</u> ft. _____ ft. and _____ ft. Gravel pack? <input checked="" type="checkbox"/> yes Size range of material <u>1/8 to 3/16</u>
<b>Clay &amp; Med. to large sand</b>			220	280	11. Static water level: _____ mo./day/yr. <u>15</u> ft. below land surface Date <u>2-4-77</u>
					12. Pumping level below land surfaces: _____ ft. after _____ hrs. pumping _____ g.p.m. _____ ft. after _____ hrs. pumping _____ g.p.m. Estimated maximum yield <u>100</u> g.p.m.
					13. Water sample submitted: _____ mo./day/yr. <input type="checkbox"/> Yes <input checked="" type="checkbox"/> No Date _____
					14. Well head completion: <input type="checkbox"/> Pitless adapter <u>28</u> inches above grade
					15. Well grouted? _____ With <input checked="" type="checkbox"/> Neat cement <input type="checkbox"/> Bentonite <input type="checkbox"/> Concrete Depth: From <u>0</u> ft. to <u>10</u> ft.
					16. Nearest source of possible contamination: ft. <u>100</u> Direction <u>NE</u> Type <u>oilwell</u> Well disinfected upon completion? <input checked="" type="checkbox"/> Yes <input type="checkbox"/> No
					17. Pump: <input checked="" type="checkbox"/> Not installed Manufacturer's name _____ Model number _____ HP _____ Volts _____ Length of drop pipe _____ ft. capacity _____ g.p.m. Type: <input type="checkbox"/> Submersible <input type="checkbox"/> Turbine <input type="checkbox"/> Jet <input type="checkbox"/> Reciprocating <input type="checkbox"/> Centrifugal <input type="checkbox"/> Other
					20. Water well contractor's certification: This well was drilled under my jurisdiction and this report is true to the best of my knowledge and belief. <b>Carlile Water Well 118</b> Business name _____ License No. _____ Address <b>Box 275, Liberal, Ks.</b> Signed <u>Edward E. Means</u> Date <u>2-18</u> Authorized representative
18. Elevation:	19. Remarks:				
Topography: <input type="checkbox"/> Hill <input type="checkbox"/> Slope <input checked="" type="checkbox"/> Upland <input type="checkbox"/> Valley					

30 270 34 1/4 1/4 1/4