

WATER WELL RECORD


Form WWC-5

Division of Water Resources App. No.

1 LOCATION OF WATER WELL: County: MEADE Fraction 1/4 SE 1/4 SE 1/4 NE 1/4 Section Number 27 Township No. T 30 S Range Number R 27 [] E [X] W

Street/Rural Address of Well Location; if unknown, distance & direction from nearest town or intersection: MEADE; 9 N on hwy 23 to E. rd, 5 E to 23 rd, 1/2 S to feedlot on W side. Global Positioning System (GPS) information: Latitude: Longitude: Elevation: Datum: Collection Method: Est. Accuracy:

2 WATER WELL OWNER: SW WINDMILL RR#, Street Address, Box #: P.O. BOX 909 City, State, ZIP Code : MEADE, KS 67864

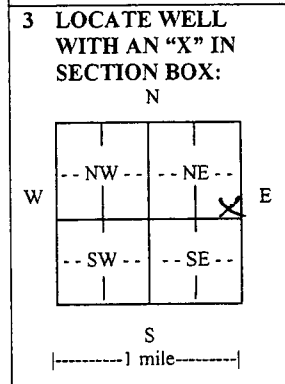

3 LOCATE WELL WITH AN 'X' IN SECTION BOX: N 4 DEPTH OF COMPLETED WELL 320 ft. Depth(s) Groundwater Encountered (1) 100 ft. (2) ft. (3) ft. WELL'S STATIC WATER LEVEL 100 ft. below land surface measured on mo/day/yr. 5-19-09 Pump test data: Well water was 231 ft. after 1 hours pumping 210 gpm EST. YIELD 210 gpm. Well water was ft. after hours pumping gpm Bore Hole Diameter 12 1/4 in. to 320 ft., and in. to ft. WELL WATER TO BE USED AS: [] Public water supply [] Geothermal [] Injection well [X] Domestic [] Feedlot [] Oil field water supply [] Dewatering [] Other (Specify below) [] Irrigation [] Industrial [] Domestic-lawn & garden [] Monitoring well Was a chemical/bacteriological sample submitted to Department? [] Yes [X] No If yes, mo/day/yr sample was submitted. Water well disinfected? [X] Yes [] No

5 TYPE OF CASING USED: [] Steel [X] PVC [] Other CASING JOINTS: [] Glued [] Clamped [] Welded [] Threaded Casing diameter 8 in. to 220 ft., Diameter in. to ft., Diameter in. to ft. Casing height above land surface 24 in., Weight 6.069 lbs./ft., Wall thickness or gauge No. SDR-21.316 TYPE OF SCREEN OR PERFORATION MATERIAL: [] Steel [] Stainless Steel [X] PVC [] Other (Specify) [] Brass [] Galvanized Steel [] None used (open hole) SCREEN OR PERFORATION OPENINGS ARE: [] Continuous slot [] Mill slot [] Gauze wrapped [] Torch cut [] Drilled holes [] None (open hole) [] Louvered shutter [] Key punched [] Wire wrapped [X] Saw cut [] Other (specify) SCREEN-PERFORATED INTERVALS: From 220 ft. to 320 ft., From ft. to ft., From ft. to ft. GRAVEL PACK INTERVALS: From 160 ft. to 320 ft., From ft. to ft., From ft. to ft.

6 GROUT MATERIAL: [X] Neat cement [] Cement grout [] Bentonite [X] Other HOLE PLUG Grout Intervals: From 1 ft. to 25 ft., From ft. to ft., From ft. to ft. What is the nearest source of possible contamination: [] Septic tank [] Lateral lines [] Pit privy [] Livestock pens [] Insecticide storage [] Other (specify below) [] Sewer lines [] Cesspool [] Sewage lagoon [] Fuel storage [] Abandoned water well [] Watertight sewer lines [] Seepage pit [] Feedyard [] Fertilizer storage [] Oil well/gas well Direction from well Distance from well

Table with columns: FROM, TO, LITHOLOGIC LOG, FROM, TO, LITHO. LOG (cont.) or PLUGGING INTERVALS. Rows include layers like CLAY TOP, SANDY CLAY, CALICHE, SAND, etc. Includes 'RECEIVED JUN 01 2009' and 'BUREAU OF WATER' stamps.

7 CONTRACTOR'S OR LANDOWNER'S CERTIFICATION: This water well was [X] constructed, [] reconstructed, or [] plugged under my jurisdiction and was completed on (mo/day/year) 5-18-09 and this record is true to the best of my knowledge and belief. Kansas Water Well Contractor's License No. KWW430. This Water Well Record was completed on (mo/day/year) 5-18-09 under the business name of Howard Drilling Box 806 Beaver, OK 73932 by (signature)

INSTRUCTIONS: Use typewriter or ball point pen. PLEASE PRESS FIRMLY and PRINT clearly. Please fill in blanks and check the correct answers. Send three copies (white, blue, pink) to Kansas Department of Health and Environment, Bureau of Water, Geology Section, 1000 SW Jackson St., Suite 420, Topeka, Kansas 66612-1367. Telephone 785-296-5522. Send one copy to WATER WELL OWNER and retain one for your records. Include fee of \$5.00 for each constructed well. Visit us at http://www.kdheks.gov/waterwell/index.html.