


1 LOCATION OF WATER WELL: Fraction SE 1/4 SW 1/4 SE 1/4 Section Number 2 Township Number T 30 Range Number R 28 E

Distance and direction from nearest town or city street address of well if located within city?  
2 miles north of Meade

2 WATER WELL OWNER: Boyd Farms Inc  
 RR#, St. Address, Box #: 2119 Rd 18 Board of Agriculture, Division of Water Resources  
 City, State, ZIP Code: Meade KS 67864 Application Number: 42,755

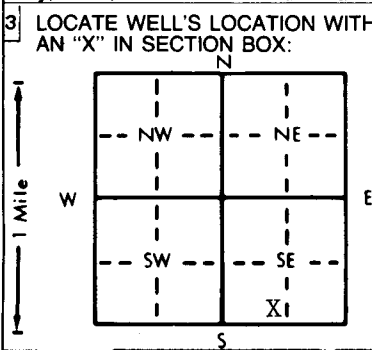

4 DEPTH OF COMPLETED WELL... 338 ft. ELEVATION: .....

Depth(s) Groundwater Encountered 1.147 ft. 2. .... ft. 3. .... ft.

WELL'S STATIC WATER LEVEL ... 147 ft. below land surface measured on mo/day/yr 12-8-98

Pump test data: Well water was 160 ft. after 1 hours pumping 930 gpm

Est. Yield 2000 gpm: Well water was 168 ft. after 2 hours pumping 1400 gpm

Bore Hole Diameter: 28 in. to 338 ft. and ..... in. to ..... ft.

WELL WATER TO BE USED AS:

5 Public water supply	8 Air conditioning	11 Injection well
1 Domestic	3 Feedlot	6 Oil field water supply
2 Irrigation	4 Industrial	7 Lawn and garden only
		10 Monitoring well

Was a chemical/bacteriological sample submitted to Department? Yes.....No...X.....; If yes, mo/day/yr sample was submitted

Water Well Disinfected? Yes X No

5 TYPE OF BLANK CASING USED:

1 Steel	3 RMP (SR)	6 Asbestos-Cement	9 Other (specify below)	CASING JOINTS: Glued ..... Clamped .....
2 PVC	4 ABS	7 Fiberglass		Welded <u>CertaLoc</u> .....
				Threaded .....

Blank casing diameter 16 in. to 198 ft., Dia ..... in. to ..... ft., Dia ..... in. to ..... ft.

Casing height above land surface 12 in., weight ..... lbs./ft. Wall thickness or gauge No. SDR26

TYPE OF SCREEN OR PERFORATION MATERIAL:

1 Steel	3 Stainless steel	5 Fiberglass	7 PVC	10 Asbestos-cement
2 Brass	4 Galvanized steel	6 Concrete tile	8 RMP (SR)	11 Other (specify) .....
			9 ABS	12 None used (open hole)

SCREEN OR PERFORATION OPENINGS ARE:

1 Continuous slot	3 Mill slot	5 Gauzed wrapped	8 Saw cut	11 None (open hole)
2 Louvered shutter	4 Key punched	6 Wire wrapped	9 Drilled holes	
		7 Torch cut	10 Other (specify) .....	

SCREEN-PERFORATED INTERVALS: From 198 ft. to 338 ft., From ..... ft. to ..... ft.

GRAVEL PACK INTERVALS: From 20 ft. to 338 ft., From ..... ft. to ..... ft.

6 GROUT MATERIAL: 1 Neat cement 2 Cement grout 3 Bentonite 4 Other .....

Grout Intervals: From 0 ft. to 20 ft., From ..... ft. to ..... ft., From ..... ft. to ..... ft.

What is the nearest source of possible contamination:

1 Septic tank	4 Lateral lines	7 Pit privy	10 Livestock pens	14 Abandoned water well
2 Sewer lines	5 Cess pool	8 Sewage lagoon	11 Fuel storage	15 Oil well/Gas well
3 Watertight sewer lines	6 Seepage pit	9 Feedyard	12 Fertilizer storage	16 Other (specify below)
			13 Insecticide storage	

Direction from well? south How many feet? 1500

FROM	TO	LITHOLOGIC LOG	FROM	TO	PLUGGING INTERVALS
0	4	top soil	330	340	brown clay
4	15	brown clay & fine sand streaks			
15	19	brown clay			
19	30	limerock			
30	40	sand fine to medium, loose			
40	51	tan clay & thin ledges			
51	59	brown clay			
59	160	sand fine to medium, course, some clay layers & few cemented ledges			
160	290	sand fine to medium course, small to medium gravel, very few large			
290	310	sand fine to medium course few small gravel & few clay streaks			
310	325	sandy clay & limerock			
325	330	sand very fine			

7 CONTRACTOR'S OR LANDOWNER'S CERTIFICATION: This water well was (1) constructed, (2) reconstructed, or (3) plugged under my jurisdiction and was completed on (mo/day/year) 12-10-98 and this record is true to the best of my knowledge and belief. Kansas Water Well Contractor's License No. 473. This Water Well Record was completed on (mo/day/yr) 12-10-98 under the business name of Tyler Water Well Service Inc. by (signature) [Signature]