


*Corrected*

1 LOCATION OF WATER WELL: Fraction NE NE 1/4 S 1/2 Section Number 18 Township Number 30 Range Number 28  
 County: Meade

Distance and direction from nearest town or city street address of well if located within city?

2 WATER WELL OWNER: Dale G Koehn  
 RR #, St. Address, Box #: 302 E Parks Board of Agriculture, Division of Water Resources  
 City, State, ZIP Code: Montezuma KS 67867 Application Number:

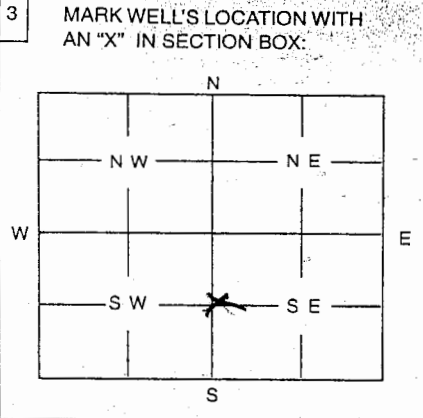

4 DEPTH OF WELL 376 ft  
 WELL'S STATIC WATER LEVEL 208 ft  
 WELL WAS USED AS:  
 1 Domestic       5 Public Water Supply       9 Dewatering  
 2 Irrigation       6 Oil Field Water Supply       10 Monitoring Well  
 3 Feedlot       7 Domestic (Lawn & Garden)       11 Injection Well  
 4 Industrial       8 Air Conditioning       12 Other .....

Was a chemical / bacteriological sample submitted to Department? Yes ..... No .....  
 If yes, mo/day/yr sample was submitted .....

Water Well Disinfected: Yes  No .....

5 TYPE OF BLANK CASING USED:  
 1 Steel       3 RMP (SR)       5 Wrought       7 Fiberglass       9 Other (Specify below)  
 2 PVC       4 ABS       6 Asbestos-Cement       8 Concrete Tile .....

Blank casing diameter 16 in. Was casing pulled? Yes ..... No  If yes, how much .....

Casing height above or below land surface ..... in.

6 GROUT PLUG MATERIAL:  1 Neat cement       2 Cement grout       3 Bentonite       4 Other .....

Grout Plug Intervals: From 7 ft. to 4 ft., From ..... ft. to ..... ft., From ..... to ..... ft.

What is the nearest source of possible contamination:  
 1 Septic tank       6 Seepage pit       11 Fuel storage       16 Other (specify below)  
 2 Sewer lines       7 Pit privy       12 Fertilizer storage .....

Direction from well? ..... How many feet? .....

FROM	TO	PLUGGING MATERIALS
376	194	Sand
194	7	clay dirt
7	4	Bentonite
Cut off	at 4	

RECEIVED  
 APR 18 2005  
 BUREAU OF WATER

7 CONTRACTOR'S OR LANDOWNER'S CERTIFICATION: This water well was plugged under my jurisdiction and was completed on (mo/day/year) 4/16/05 and this record is true to the best of my knowledge and belief. Kansas Water Well Contractor's License No. .... This Water Well Record was completed on (mo/day/year) ..... under the business name of ..... by (signature) Dale G Koehn