


1 LOCATION OF WATER WELL: County: Meade Fraction: SW 1/4 SW 1/4 SE 1/4 Section Number: 7 Township Number: T 30 S Range Number: R 28 E/W

Distance and direction from nearest town or city street address of well if located within city? From west side of Meade - 5 Miles West, 10 Miles North, 1 Mile East, 1 Mile North, 2,585 Ft. West & 100 Ft. North

2 WATER WELL OWNER: Otis Elliott
 RR#, St. Address, Box #: R R 1
 City, State, ZIP Code: Montezuma, Kansas 67867
 Board of Agriculture, Division of Water Resources
 Application Number: 35,095

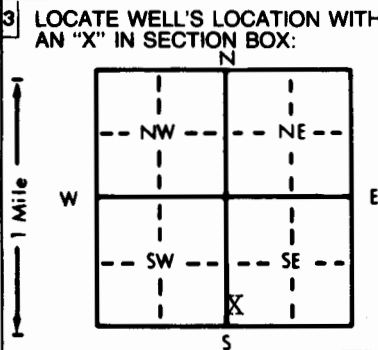

4 DEPTH OF COMPLETED WELL: 380 ft. ELEVATION: _____
 Depth(s) Groundwater Encountered 1. _____ ft. 2. _____ ft. 3. _____ ft.
 WELL'S STATIC WATER LEVEL: 26.150 ft. below land surface measured on mo/day/yr 12-13-82
 Pump test data: Well water was _____ ft. after _____ hours pumping _____ gpm
 Est. Yield _____ gpm: Well water was _____ ft. after _____ hours pumping _____ gpm
 Bore Hole Diameter: 26 in. to 380 ft., and _____ in. to _____ ft.
 WELL WATER TO BE USED AS:
 5 Public water supply 8 Air conditioning 11 Injection well
 1 Domestic 3 Feedlot 6 Oil field water supply 9 Dewatering 12 Other (Specify below)
 ② Irrigation 4 Industrial 7 Lawn and garden only 10 Monitoring well _____
 Was a chemical/bacteriological sample submitted to Department? Yes _____ No X; If yes, mo/day/yr sample was submitted _____
 Water Well Disinfected? Yes _____ No X

5 TYPE OF BLANK CASING USED:
 ① Steel 3 RMP (SR) 5 Wrought iron 8 Concrete tile CASING JOINTS: Glued _____ Clamped _____
 2 PVC 4 ABS 6 Asbestos-Cement 9 Other (specify below) Welded X
 7 Fiberglass _____ Threaded _____
 Blank casing diameter: 16 in. to 200 ft., Dia _____ in. to _____ ft., Dia _____ in. to _____ ft.
 Casing height above land surface: 12 in., weight 42.05 lbs./ft. Wall thickness or gauge No. 250
 TYPE OF SCREEN OR PERFORATION MATERIAL:
 ① Steel 3 Stainless steel 5 Fiberglass 7 PVC 10 Asbestos-cement
 2 Brass ④ Galvanized steel 6 Concrete tile 8 RMP (SR) 11 Other (specify) _____
 12 None used (open hole)
 SCREEN OR PERFORATION OPENINGS ARE:
 1 Continuous slot ③ Mill slot 5 Gauzed wrapped 8 Saw cut 11 None (open hole)
 2 Louvered shutter 4 Key punched ⑥ Wire wrapped 9 Drilled holes
 7 Torch cut 10 Other (specify) _____
 SCREEN-PERFORATED INTERVALS: From 200 ft. to 380 ft., From _____ ft. to _____ ft.
 From _____ ft. to _____ ft., From _____ ft. to _____ ft.
 GRAVEL PACK INTERVALS: From 10 ft. to 380 ft., From _____ ft. to _____ ft.
 From _____ ft. to _____ ft., From _____ ft. to _____ ft.

6 GROUT MATERIAL: 1 Neat cement ② Cement grout 3 Bentonite 4 Other _____
 Grout intervals: From 0 ft. to 10 ft., From _____ ft. to _____ ft., From _____ ft. to _____ ft.
 What is the nearest source of possible contamination:
 1 Septic tank 4 Lateral lines 7 Pit privy 10 Livestock pens 14 Abandoned water well
 2 Sewer lines 5 Cess pool 8 Sewage lagoon 11 Fuel storage 15 Oil well/Gas well
 3 Watertight sewer lines 6 Seepage pit 9 Feedyard 12 Fertilizer storage 16 Other (specify below)
 13 Insecticide storage _____ N/A _____
 Direction from well? _____ How many feet? _____

FROM	TO	LITHOLOGIC LOG	FROM	TO	PLUGGING INTERVALS
		See attached log			

7 CONTRACTOR'S OR LANDOWNER'S CERTIFICATION: This water well was ① constructed, (2) reconstructed, or (3) plugged under my jurisdiction and was completed on (mo/day/year) 12-28-82 and this record is true to the best of my knowledge and belief. Kansas Water Well Contractor's License No. 208 This Water Well Record was completed on (mo/day/yr) 1-22-83 under the business name of Minter-Wilson Drilling Co., Inc. by (signature) Rosa Keller

Professionals

MINTER-WILSON DRILLING CO.

INCORPORATED

Irrigation
and Domestic
Water Systems
Complete Installation
and Repairing

Phone 276-8269 • P.O. Box A • GARDEN CITY, KANSAS 67846

OTTIS ELLIOTT
MEADE COUNTY

4/13/81

SE

Location: ~~SW~~ 7-30-28- from east side of Montezuma 11 miles
south $\frac{1}{2}$ east - north side of road

Static Water Level - 150'

Test

- 0 1 Top Soil
- 1 150¹ Brown Clay
- 15 83⁸ Fine to Med. Sand (loose)
- 83 98⁰ Brown Clay
- 98 125 Fine to Med. Sand & Gravel (Loose)
- 125 170¹ Fine to Med. Sand & Gravel 10% Clay (loose)
- 170 185⁰ Brown & Gray Clay
- 185 191 Fine to Med. Sand & Gravel 15% Clay (Loose)
- 191 224¹ Fine to Med. Sand & Gravel 10% Clay (Loose)
- 224 233⁴ Brown Sandy Clay
- 233 343⁷ Fine to Med. Sand Gravel 10% Clay (loose)
- 343 352⁴ Brown Sandy Clay 30% Gravel
- 352 373¹ Fine to Med. Sand and Gravel 10% Clay (Loose)
- 373 380³⁵ Brown Sandy Clay Streaks of Gravel 30%
(Loose)
- 380 395⁴ Brown Sandy Clay
- 395 434 Brown & Gray Clay with White Rock (Tight)
(Hard Streaks)
- 434 451⁵ Gray Brown & Yellow Clay with Brown Rock
(Hard)
- 451 455⁹ Yellow Clay & Shale

T.D. 480' 380'