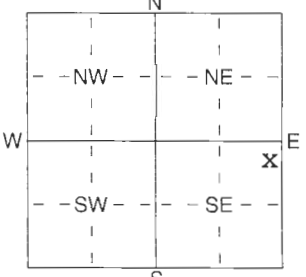


1 LOCATION OF WATER WELL: County Meade Fraction NE 1/4 NE 1/4 SE 1/4 Section Number 36 Township Number T 30 S Range Number R 28 E/W

Distance and direction from nearest town or city street address of well if located within city?  
7 Miles West & 1/2 Mile North of Fowler

2 WATER WELL OWNER: Frank Devine  
 RR#, St. Address, Box # : P.O. Box 489 Board of Agriculture, Division of Water Resources  
 City, State, ZIP Code : Meade, Kansas 67864 Application Number: 30473

3 LOCATE WELL'S LOCATION WITH AN "X" IN SECTION BOX:  4 DEPTH OF COMPLETED WELL ..... 318 ..... ft. ELEVATION: .....

Depth(s) Groundwater Encountered 1 ..... 1.72 ..... ft. 2 ..... 1.81 ..... ft. 3 ..... 2.97 ..... ft.  
 WELL'S STATIC WATER LEVEL ..... 34 ..... ft. below land surface measured on mo/day/yr ..... 7-14-07 .....  
 Pump test data: Well water was ..... ft. after ..... hours pumping ..... gpm  
 Est. Yield ..... 800 ..... gpm: Well water was ..... ft. after ..... hours pumping ..... gpm  
 WELL WATER TO BE USED AS: 5 Public water supply 8 Air conditioning 11 Injection well  
 1 Domestic 3 Feedlot 6 Oil field water supply 9 Dewatering 12 Other (Specify below)  
 2 Irrigation 4 Industrial 7 Domestic (lawn & garden) 10 Monitoring well .....

Was a chemical/bacteriological sample submitted to Department? Yes ..... No X ..... ; If yes, mo/day/yr sample was submitted  
 Water Well Disinfected? Yes X No

5 TYPE OF BLANK CASING USED: 1 Steel 3 RMP (SR) 5 Wrought iron 8 Concrete tile CASING JOINTS: Glued X & Bolted .....  
 2 PVC 4 ABS 6 Asbestos-Cement 9 Other (specify below) Welded .....  
 7 Fiberglass Threaded .....

Blank casing diameter ..... 16 ..... in. to ..... 298 ..... ft., Dia ..... in. to ..... ft., Dia ..... in. to ..... ft.  
 Casing height above land surface ..... 12 ..... in., weight ..... lbs./ft. Wall thickness or guage No. SDR26 .....

TYPE OF SCREEN OR PERFORATION MATERIAL: 1 Steel 3 Stainless Steel 5 Fiberglass 8 RMP (SR) 10 Asbestos-Cement  
 2 Brass 4 Galvanized Steel 6 Concrete tile 9 ABS 11 Other (Specify) .....  
 12 None used (open hole)

SCREEN OR PERFORATION OPENINGS ARE: 1 Continuous slot 3 Mill slot 5 Guazed wrapped 8 Saw cut 11 None (open hole)  
 2 Louvered shutter 4 Key punched 6 Wire wrapped 9 Drilled holes  
 7 Torch cut 10 Other (specify) ..... ft.

SCREEN-PERFORATED INTERVALS: From ..... 298 ..... ft. to ..... 318 ..... ft., From ..... ft. to ..... ft.  
 GRAVEL PACK INTERVALS: From ..... 20 ..... ft. to ..... 318 ..... ft., From ..... ft. to ..... ft.

6 GROUT MATERIAL: 1 Neat cement 2 Cement grout 3 Bentonite 4 Other .....

Grout Intervals: From ..... 20-16 Bentonite ..... ft., From ..... 16-0 Cement ..... ft., From ..... ft. to ..... ft.

What is the nearest source of possible contamination:  
 1 Septic tank 4 Lateral lines 7 Pit privy 10 Livestock pens 14 Abandoned water well  
 2 Sewer lines 5 Cess pool 8 Sewage lagoon 11 Fuel storage 15 Oil well/Gas well  
 3 Watertight sewer lines 6 Seepage pit 9 Feedyard 12 Fertilizer storage 16 Other (specify below)  
 13 Insecticide storage .....

Direction from well? How many feet?

FROM	TO	LITHOLOGIC LOG	FROM	TO	PLUGGING INTERVALS
0	15	Topsoil & clay & lime	169	171	Sand (fine)
15	30	Clay & lime	171	172	Clay
30	45	Clay & little lime	172	180	Sand
45	57	Clay with lime	180	181	Clay
57	58	Lime (very hard)	181	198	Sand
58	60	Clay & little lime	198	207	Clay
60	75	Lime with clay	207	210	Sand (little fine)
75	80	Fine sand & clay	210	240	Clay & little lime
80	90	Clay turn blue with lime	240	241	Clay
90	105	Clay & little lime	241	249	Sand (little fine)
105	125	Clay (blue) & little lime	249	267	Clay & little lime
125	135	Clay & fine sand	267	292	Lime & clay
135	157	Sand (fine)	292	297	Sand (fine & tight)
157	169	Clay & little lime	297	313	Sand

7 CONTRACTOR'S OR LANDOWNER'S CERTIFICATION: This water well was (1) constructed, (2) reconstructed or (3) plugged under my jurisdiction and was completed on (mo/day/year) ..... 7-14-07 ..... and this record is true to the best of my knowledge and belief. Kansas Water Well Contractor's Licence No ..... 223 ..... This Water Well Record was completed on (mo/day/yr) ..... 7-30-07 ..... under the business name of Dunham Drilling Inc. by (signature) Karen Dunham