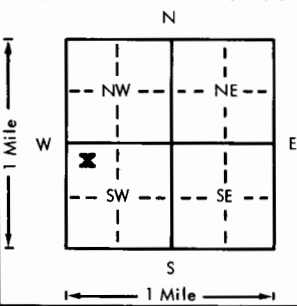


USE TYPEWRITER OR BALL POINT PEN—PRESS FIRMLY, PRINT CLEARLY.

WATER WELL RECORD
KSA 82a-1201-1215

Kansas Department of Health and Environment—Division of Environment (Water well Contractors) Topeka, Kansas 66620

<input checked="" type="checkbox"/> Location of well:	County Meade County	Fraction NW 1/4 NW 1/4 SW 1/4	Section number 7	Township number T 30 S R 28 E/W	Range number 28
2. Distance and direction from nearest town or city: 11 South, 1/8 East from East side of Montezuma <small>Street address or well location if in city:</small>			3. Owner of well: Otis Elliott R.R. or street: Montezuma, KS 67867 City, state, zip code:		
4. Locate with "X" in section below: Sketch map: 			6. Bore hole dia. 26 in. Completion date 10-31-78 Well depth 340 ft.		
5. Type and color of material			7. <input type="checkbox"/> Cable tool <input type="checkbox"/> Rotary <input type="checkbox"/> Driven <input type="checkbox"/> Dug <input type="checkbox"/> Hollow rod <input type="checkbox"/> Jetted <input type="checkbox"/> Bored <input checked="" type="checkbox"/> Reverse rotary		
			8. Use: <input type="checkbox"/> Domestic <input type="checkbox"/> Public supply <input type="checkbox"/> Industry <input checked="" type="checkbox"/> Irrigation <input type="checkbox"/> Air conditioning <input type="checkbox"/> Stock <input type="checkbox"/> Lawn <input type="checkbox"/> Oil field water <input type="checkbox"/> Other		
			9. Casing: Material Steel Height: Above or below Threaded <input type="checkbox"/> Welded <input checked="" type="checkbox"/> Surface 1 ft. in. RMP <input type="checkbox"/> PVC <input type="checkbox"/> Weight 36.87 lbs./ft. Dia 16 in. to 340 ft. depth Wall Thickness: inches or Dia. <input type="checkbox"/> in. to <input type="checkbox"/> ft. depth gage No. .219		
			10. Screen: Manufacturer's name Johnson Type Johnson Galv. Di. 100-16" Slot/gauze 0-170 Plain gage 170-290 Perf. Set between 290-330 Screen 330-340 Perf. ft. and <input type="checkbox"/> ft. Gravel pack? yes Size range of material 1/2 to 5/8		
			11. <input checked="" type="checkbox"/> Static water level: <input type="checkbox"/> mo./day/yr. 140 ft. below land surface Date 10-3-78		
			12. Pumping level below land surfaces: 152 ft. after 2 hrs. pumping 1275 g.p.m. 158 ft. after 4 hrs. pumping 1575 g.p.m. Estimated maximum yield 1575 g.p.m.		
			13. Water sample submitted: <input type="checkbox"/> Yes <input checked="" type="checkbox"/> No Date <input type="checkbox"/>		
			14. Well head completion: <input type="checkbox"/> Pitless adapter 1 ft. inches above grade		
			15. Well grouted? yes With: <input type="checkbox"/> Neat cement <input type="checkbox"/> Bentonite <input checked="" type="checkbox"/> Concrete Depth: From 0 ft. to 10 ft.		
			16. Nearest source of possible contamination: ft. <input type="checkbox"/> Direction N/A Type <input type="checkbox"/> <input checked="" type="checkbox"/> Well disinfected upon completion? <input type="checkbox"/> Yes <input checked="" type="checkbox"/> No		
17. Pump: <input type="checkbox"/> Not installed Manufacturer's name Gould 3 stg. 14" Model number 152933 HP 200 Volts <input type="checkbox"/> Length of drop pipe 220 ft. capacity 1200 p.m. Type: <input type="checkbox"/> Submersible <input checked="" type="checkbox"/> Turbine <input type="checkbox"/> Jet <input type="checkbox"/> Reciprocating <input type="checkbox"/> Centrifugal <input type="checkbox"/> Other					
(Use a second sheet if needed)					
18. Elevation: Topography: <input type="checkbox"/> Hill <input type="checkbox"/> Slope <input checked="" type="checkbox"/> Upland <input type="checkbox"/> Valley	19. Remarks:		20. Water well contractor's certification: This well was drilled under my jurisdiction and this report is true to the best of my knowledge and belief. Minter-Wilson Drilling Co. 208 Business name License No. <input type="checkbox"/> Address Box A, Garden City, KS 67844 Signature <i>[Signature]</i> Date 10-29-78 Authorized representative		

30 260 E - 7 NW 1/4 SW

The Professionals

MINTER-WILSON DRILLING CO.

INCORPORATED

Irrigation
and Domestic
Water Systems
Complete Installation
and Repairing

Phone 276-8269

P.O. Box A

GARDEN CITY, KANSAS 67846

OTIS ELLIOTT
MEADE COUNTY
7-26-77

Location: SW 7-30-28 11 south of Montezuma in
Otis Elliott's yard in northeast corner

Static Water Level- 115'

Test #1

0	4	Top soil
4	33	Brown clay
33	81	Fine sand
81	98	Brown clay
98	151	Fine to med. sand and gravel
151	156	Brown clay
156	191	Fine to med. sand and gravel
191	205	Brown clay
205	338	Fine to med. sand and gravel
338	429	Brown clay
429	436	Brown and yellow clay
436	440	Shale

t.d. 340'
Screen