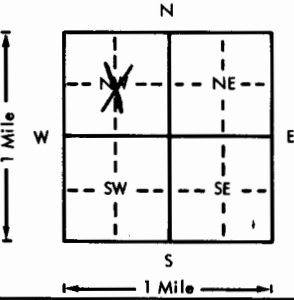


USE TYPEWRITER OR BALL
POINT PEN-PRESS FIRMLY,
PRINT CLEARLY.

WATER WELL RECORD
KSA 82a-1201-1215

Kansas Department of Health and
Environment-Division of Environment
(Water well Contractors)
Topeka, Kansas 66620

1. Location of well:	County MEADE	Fraction NW 1/4 SE 1/4 NW/4	Section number 8	Township number T 30 S R 28	Range number 28
2. Distance and direction from nearest town or city: 11 south 1 east 1/2 north 1/8 east of east side of Montezuma Street address of well location if in city:			3. Owner of well: Lonnæ Schmidt R.R. or street: Montezuma, Ks 67867 City, state, zip code:		
4. Locate with "X" in section below: Sketch map: 			6. Bore hole dia. 26 in. Completion date 4-30-76 Well depth 380 ft.		
5. Type and color of material			7. <input type="checkbox"/> Cable tool <input type="checkbox"/> Rotary <input type="checkbox"/> Driven <input type="checkbox"/> Dug <input type="checkbox"/> Hollow rod <input type="checkbox"/> Jetted <input type="checkbox"/> Bored <input checked="" type="checkbox"/> Reverse rotary		
			8. Use: <input type="checkbox"/> Domestic <input type="checkbox"/> Public supply <input type="checkbox"/> Industry <input checked="" type="checkbox"/> Irrigation <input type="checkbox"/> Air conditioning <input type="checkbox"/> Stock <input type="checkbox"/> Lawn <input type="checkbox"/> Oil field water <input type="checkbox"/> Other		
			9. Casing: Material <u>Steel</u> Height: Above or below Threaded <input type="checkbox"/> Welded <input checked="" type="checkbox"/> Surface <u>12</u> in. RMP <input type="checkbox"/> PVC <input type="checkbox"/> Weight <u>36.87</u> lbs./ft. Dia. <u>16</u> in. to <u>387</u> depth Wall Thickness: inches or Dia. <u> </u> in. to <u> </u> ft. depth gage No. <u> </u>		
			10. Screen: Manufacturer's name Johnson Division Type <u>Galv.</u> Dia. <u>16"</u> Slot/gauze <u>100</u> Length <u>20'</u> Set between <u>340</u> ft. and <u>360</u> ft. Perf. <u>140-340</u> ft. and <u>360-380</u> ft. Gravel pack? <input checked="" type="checkbox"/> Size range of material <u>1/2" Down</u>		
			11. Static water level: <u> </u> mo./day/yr. <u>116</u> ft. below land surface Date <u>4-14-76</u>		
			12. Pumping level below land surfaces: <u>139</u> ft. after <u>3</u> hrs. pumping <u>2350</u> g.p.m. <u> </u> ft. after <u> </u> hrs. pumping <u> </u> g.p.m. Estimated maximum yield <u>2300</u> g.p.m.		
			13. Water sample submitted: <u> </u> mo./day/yr. Yes <input checked="" type="checkbox"/> No <input type="checkbox"/> Date <u> </u>		
			14. Well head completion: <input type="checkbox"/> Pitless adapter <u>12</u> inches above grade		
			15. Well grouted? <input checked="" type="checkbox"/> yes With: <input type="checkbox"/> Neat cement <input type="checkbox"/> Bentonite <input type="checkbox"/> Concrete Depth: From <u>0</u> ft. to <u>10</u> ft.		
			16. Nearest source of possible contamination: <u>N/A</u> ft. <u> </u> Direction <u> </u> Type <u> </u> Well disinfected upon completion? <input type="checkbox"/> Yes <input checked="" type="checkbox"/> No		
17. Pump: <u>Goussard</u> Not installed Manufacturer's name <u>Goussard US pumps</u> Model number <u>14JHC</u> HP <u>200</u> Volts <u> </u> Length of drop pipe <u>240</u> ft. capacity <u>1900</u> g.p.m. Type: <input type="checkbox"/> Submersible <input checked="" type="checkbox"/> Turbine <input type="checkbox"/> Jet <input type="checkbox"/> Reciprocating <input type="checkbox"/> Centrifugal <input type="checkbox"/> Other					
(Use a second sheet if needed)					
18. Elevation:	19. Remarks:		20. Water well contractor's certification: This well was drilled under my jurisdiction and this report is true to the best of my knowledge and belief. Walter Wislon Drilling 208 Business name <u>P.O. Box A Garden City, Ks</u> License No. <u> </u> Address <u> </u> Date <u>7-16-76</u> Signed <u> </u> Authorized representative		
Topography: <input type="checkbox"/> Hill <input checked="" type="checkbox"/> Slope <input type="checkbox"/> Upland <input type="checkbox"/> Valley					

Forward the white, blue and pink copies to the Department of Health and Environment

Form WWC-5

T
R
E
S
S
E
C
1/4 1/4 1/4
 30 28 28
 WILSON

The
Professionals

MINTER-WILSON DRILLING CO.
INCORPORATED

Irrigation
and Domestic
Water Systems
Complete Installation
and Repairing

Phone 276-8269 • P.O. Box 493 • GARDEN CITY, KANSAS 67846

Location: From south east corner of Montezuma 11 Mile
South, 1 mile east, ½ mile north, 100 yds east
Lonnie Schmidt

Monroe County
1-13-76
NW 8-30-28
Static 120

Test #3

0	2	Top Soil
2	4	Brown Clay
4	34	Brown sandy clay
34	50	Brown & White sandy clay
50	81	Brown sandy clay
81	95	Fine to med sand (tight)
95	112	Fine to med sand & fine gravel (loose)
112	200	Fine to med sand & gravel (loose)
200	209	Fine to med sand & gravel some coarse sand streak of clay (10%)
209	260	Fine to med sand & gravel (loose)
260	275	Fine to med sand streaks of clay (10%)
275	318	Fine sand & clay mixture (tight)
318	333	Fine to med sand streaks of clay (10%)
333	358	Fine to med sand & gravel (loose)
358	365	Fine to med sand & gravel small streaks of white rock(10%)
365	380	Fine to med sand & gravel streaks of white rock (15%)
380	395	Fine sand & clay mixture (tight)