

USE TYPEWRITER OR BALL POINT PEN-PRESS FIRMLY, PRINT CLEARLY.


WATER WELL RECORD
KSA 82a-1201-1215

T R EW sec 1/4 1/4 1/4 No.

Kansas State Dept. Of Health
(Water Well Contractors)
Forbes-Bldg. 740
Topeka, Kansas 66620

1 Location of well: County **MEADE** Township name **CROCKED CREEK** Fraction **SE 1/4** Section number **13** Town number **30** Range number **28**

Distance and direction from nearest town or city: **FOWLER KAN. - 8 mi. west** **3 NORTH**
Street address of well location if in city: **3 E - 1 N**
3 Owner of well: **HOWARD YOUNG**
Address: **2410 BELL DODGE CITY KAN**

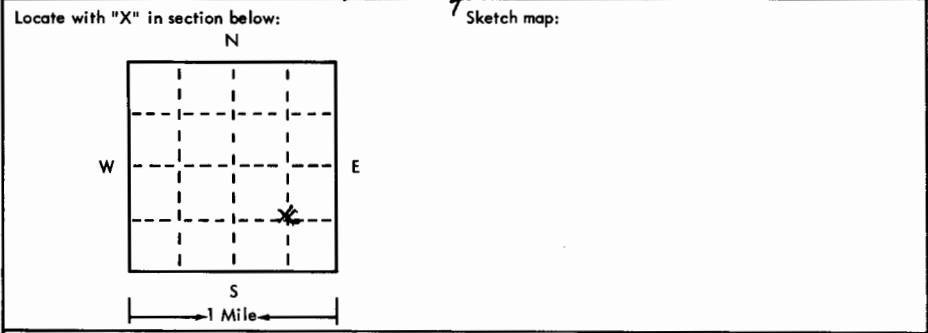

4 Well depth: **306** ft. Date of completion _____
Well diameter **2 1/2** in.
5 Cable tool Rotary Driven Dug
 Hollow rod Jetted Bored Reverse rotary
6 Use: Domestic Public supply Industry
 Irrigation Air conditioning Commercial
 Test well _____
7 Casing: Material **STEEL** Height: above/below
Threaded Welded Surface _____ in.
Diam. _____ Weight _____ lbs./ft. _____
1 1/2 in. to **306** ft. depth! Drive shoe? Yes No
_____ in. to _____ ft. depth!

2	Type and color of material	From	To
	SURFACE	0	2
	CLAY	2	15
	SAND	15	37
	CALICHE, CLAY & SAND LAYERS	37	53
	SAND ROCK LAYERS - CALICHE	53	64
	FINE SAND	64	114
	MED. FINE SAND - RUSTY COLOR	114	132
	BLACK COLOR	132	143
	SAND	143	162
	SAND & CLAY LAYERS	162	166
	MED SAND & GRAVEL	166	180
	CLAY	180	182
	SAND	182	184
	BLACK CLAY	184	203
	MED SAND & GRAVEL	203	246
	ROCK LAYERS & CLAY	246	252

8 Screen:
Manufacturer **WABROWN**
Type **BRIDGE** Dia. **1 1/2**
Slot/gauze **1/8** Length **200**
Set between **106** ft. and **306** ft. _____
Fittings:
Gravel pack Yes No Size range of material _____

9 Static water level:
50 ft. below land surface Date _____

10 Pumping level below land surfaces:
120 ft. after **1** hrs. pumping **1150** g.p.m.
_____ ft. after _____ hrs. pumping _____ g.p.m.
Estimated maximum yield **2000** g.p.m.

11 Water sample submitted:
 Yes No Date _____

12 Well head completion:
 Pitless adapter Inches above grade

13 Well grouted? Yes No
 Neat cement Bentonite _____
Depth: From _____ ft. to **10** ft.

14 Nearest source of possible contamination:
ft. _____ Direction _____ Type _____
Well disinfected upon completion? Yes No

15 Pump: Not installed
Manufacturer's name **LANE BOWLER**
Model number _____ HP _____ Volts _____
Length of drop pipe **160** ft. capacity **650** g.m.p.
Type:
 Submersible Turbine
 Jet Reciprocating
 Centrifugal Other

16 Remarks: elevation

Topography:
 Hill
 Slope
 Upland
 Valley

17 Water well contractor's certification:
This well was drilled under my jurisdiction and this report is true to the best of my knowledge and belief.
JOJOHNSON DRILLING
Business name License No. _____
Address **DODGE CITY KAN 183**
Signed **J. O. Johnson** Date **6-2-75**
Authorized representative

USE TYPEWRITER OR BALL POINT PEN-PRESS FIRMLY, PRINT CLEARLY.

WATER WELL RECORD
KSA 82a-1201-1215

T R EW sec 1/4 1/4 1/4 No.

Kansas State Dept. Of Health
(Water Well Contractors)
Forbes-Bldg. 740
Topeka, Kansas 66620

1 Location of well:	County MEADE	Township name CROOKED CREEK	Fraction SE 1/4 CENTER	Section number 13	Town number 30	Range number 28	
Distance and direction from nearest town or city: 8 mi. west FORLER KAVO K23 - 3 mi. N - 3/4 E 1/4 N			3 Owner of well: HOWARD YOUNG Address: 2410 BELL DODGE CITY KAN	
Locate with "X" in section below: N W E S 1 Mile			Sketch map:			4 Well depth: 306 ft. Date of completion _____ Well diameter _____ in.	
<table border="1" style="width:100%; border-collapse: collapse;"> <tr> <th style="width:70%;">2 Type and color of material</th> <th style="width:10%;">From</th> <th style="width:20%;">To</th> </tr> <tr> <td>MED. SAND + GRAVEL</td> <td>252</td> <td>273</td> </tr> <tr> <td>HARD LAYER</td> <td>273</td> <td>274</td> </tr> <tr> <td>MED. SAND + GRAVEL</td> <td>294</td> <td>300</td> </tr> <tr> <td>FINE SAND + ROCK LAYERS</td> <td>300</td> <td>310</td> </tr> <tr> <td>FINE SAND + SAND ROCK</td> <td>310</td> <td>319</td> </tr> <tr> <td>HARD LAYERS - CALICHE CLAY</td> <td>319</td> <td>343</td> </tr> <tr> <td> </td> <td> </td> <td> </td> </tr> <tr> <td colspan="3" style="text-align: center;">(use a second sheet if needed)</td> <td colspan="3">5 <input type="checkbox"/> Cable tool <input type="checkbox"/> Rotary <input type="checkbox"/> Driven <input type="checkbox"/> Dug <input type="checkbox"/> Hollow rod <input type="checkbox"/> Jetted <input type="checkbox"/> Bored <input checked="" type="checkbox"/> Reverse rotary</td> </tr> <tr> <td colspan="3">6 Use: <input type="checkbox"/> Domestic <input type="checkbox"/> Public supply <input type="checkbox"/> Industry <input checked="" type="checkbox"/> Irrigation <input type="checkbox"/> Air conditioning <input type="checkbox"/> Commercial <input type="checkbox"/> Test well <input type="checkbox"/> _____</td> <td colspan="3">7 Casing: Material _____ Height: above/below _____ Threaded <input type="checkbox"/> Welded <input type="checkbox"/> Surface _____ in. Diam. _____ Weight _____ lbs./ft. _____ _____ in. to _____ ft. depth! Drive shoe? <input type="checkbox"/> Yes <input type="checkbox"/> No _____ in. to _____ ft. depth!</td> </tr> <tr> <td colspan="3">8 Screen: Manufacturer WABROWN Type BRIDGE Dia. _____ Slot/gauze 1/2 Length _____ Set between _____ ft. and _____ ft. Fittings: Gravel pack <input checked="" type="checkbox"/> Yes <input type="checkbox"/> No Size range of material _____</td> <td colspan="3">9 Static water level: 80 ft. below land surface Date _____</td> </tr> <tr> <td colspan="3">10 Pumping level below land surfaces: 100 ft. after 1 hrs. pumping 150 g.p.m. _____ ft. after _____ hrs. pumping _____ g.p.m. Estimated maximum yield 2000 g.p.m.</td> <td colspan="3">11 Water sample submitted: <input type="checkbox"/> Yes <input checked="" type="checkbox"/> No Date _____</td> </tr> <tr> <td colspan="3">12 Well head completion: <input type="checkbox"/> Pitless adapter <input checked="" type="checkbox"/> Inches above grade</td> <td colspan="3">13 Well grouted? <input checked="" type="checkbox"/> Yes <input type="checkbox"/> No <input type="checkbox"/> Neat cement <input type="checkbox"/> Bentonite <input checked="" type="checkbox"/> CEMENT Depth: From _____ ft. to 12 ft.</td> </tr> <tr> <td colspan="3">14 Nearest source of possible contamination: ft. _____ Direction _____ Type _____ Well disinfected upon completion? <input type="checkbox"/> Yes <input type="checkbox"/> No</td> <td colspan="3">15 Pump: <input type="checkbox"/> Not installed Manufacturer's name LAKE BOYDLE R Model number _____ HP 100 Volts _____ Length of drop pipe 160 ft. capacity _____ g.m.p. Type: <input type="checkbox"/> Submersible <input checked="" type="checkbox"/> Turbine <input type="checkbox"/> Jet <input type="checkbox"/> Reciprocating <input type="checkbox"/> Centrifugal <input type="checkbox"/> Other</td> </tr> <tr> <td colspan="3">16 Remarks: elevation Topography: <input type="checkbox"/> Hill <input type="checkbox"/> Slope <input type="checkbox"/> Upland <input type="checkbox"/> Valley</td> <td colspan="3">17 Water well contractor's certification: This well was drilled under my jurisdiction and this report is true to the best of my knowledge and belief. JOJOHNSON DRILLING Business name License No. _____ Address DODGE CITY KAN 183 Signed JOJOHNSON Date 6-2 Authorized representative</td> </tr>




Forward the white, blue and pink copies to the Kansas State Dept. Of Health.

Form WWC-5

PAGE 2