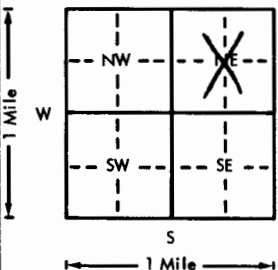
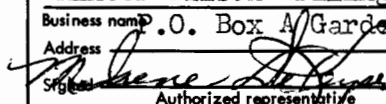


USE TYPEWRITER OR BALL POINT PEN-PRESS FIRMLY, PRINT CLEARLY.

WATER WELL RECORD  
KSA 82a-1201-1215

Kansas Department of Health and Environment-Division of Environment (Water well Contractors)  
Topeka, Kansas 66620

1. Location of well:		County <b>MEADE</b>	Fraction <b>NE 1/4 SW 1/4 NE 1/4</b>	Section number <b>27</b>	Township number <b>T 30 S</b>	Range number <b>R 28</b>	<b>EW</b>
2. Distance and direction from nearest town or city: <b>12 1/2 south of Montezuma 3 1/2 east 1/4 south</b> Street address of well location if in city:				3. Owner of well: <b>Mark Miller</b> R.R. or street: <b>Meade, Ks. 67864</b> City, state, zip code:			
4. Locate with "X" in section below: N  Sketch map:				6. Bore hole dia. <b>26</b> in. Completion date _____ Well depth <b>360</b> ft.			
5. Type and color of material				From		To	
				7. <input type="checkbox"/> Cable tool <input type="checkbox"/> Rotary <input type="checkbox"/> Driven <input type="checkbox"/> Dug <input type="checkbox"/> Hollow rod <input type="checkbox"/> Jetted <input type="checkbox"/> Bored <input checked="" type="checkbox"/> Reverse rotary			
				8. Use: <input type="checkbox"/> Domestic <input type="checkbox"/> Public supply <input type="checkbox"/> Industry <input checked="" type="checkbox"/> Irrigation <input type="checkbox"/> Air conditioning <input type="checkbox"/> Stock <input type="checkbox"/> Lawn <input type="checkbox"/> Oil field water <input type="checkbox"/> Other			
				9. Casing: Material <b>steel</b> Height: Above or below Threaded _____ Welded <input checked="" type="checkbox"/> Surface <b>12</b> in. RMP _____ PVC _____ Weight <b>36.87</b> lbs./ft. Dia. <b>16</b> in. to <b>361</b> ft. depth Wall Thickness: inches or Dia. _____ in. to _____ ft. depth gage No. _____			
				10. Screen: Manufacturer's name <b>Johnson Division</b> Type <b>Galv.</b> Dia. <b>16"</b> Slot/gauze <b>100</b> Length <b>20'</b> Set between <b>320</b> ft. and <b>340</b> ft. Perf. <b>160-320</b> ft. and <b>340-360</b> ft. Gravel pack? <input checked="" type="checkbox"/> Yes Size range of material <b>1/2" Down</b>			
				11. Static water level: _____ mo./day/yr. <b>94</b> ft. below land surface Date <b>5-11-76</b>			
				12. Pumping level below land surfaces: <b>111</b> ft. after <b>2</b> hrs. pumping <b>825</b> g.p.m. <b>121</b> ft. after <b>4</b> hrs. pumping <b>1475</b> g.p.m. Estimated maximum yield <b>1475</b> g.p.m.			
				13. Water sample submitted: _____ mo./day/yr. <input checked="" type="checkbox"/> Yes <input type="checkbox"/> No Date _____			
				14. Well head completion: <b>12</b> <input type="checkbox"/> Pitless adapter _____ Inches above grade			
				15. Well grouted? <input checked="" type="checkbox"/> Yes With: <input type="checkbox"/> Neat cement <input checked="" type="checkbox"/> Bentonite <input type="checkbox"/> Concrete Depth: From <b>0</b> ft. to <b>10</b> ft.			
16. Nearest source of possible contamination: _____ N/A ft. _____ Direction _____ Type _____ Well disinfected upon completion? <input type="checkbox"/> Yes <input checked="" type="checkbox"/> No							
17. Pump: _____ Not installed Manufacturer's name <b>Goulds US Pumps</b> Model number <b>12 JHC</b> HP <b>125</b> Volts _____ Length of drop pipe <b>180</b> ft. capacity <b>1000</b> g.p.m. Type: <input type="checkbox"/> Submersible <input checked="" type="checkbox"/> Turbine <input type="checkbox"/> Jet <input type="checkbox"/> Reciprocating <input type="checkbox"/> Centrifugal <input type="checkbox"/> Other							
(Use a second sheet if needed)							
18. Elevation:		19. Remarks:		20. Water well contractor's certification: This well was drilled under my jurisdiction and this report is true to the best of my knowledge and belief. <b>Minter Wilson Drilling 208</b> Business name <b>P.O. Box A Garden City, Ks.</b> Address _____  Date <b>8-19-76</b> Authorized representative			
Topography: <input type="checkbox"/> Hill <input checked="" type="checkbox"/> Slope <input type="checkbox"/> Upland <input type="checkbox"/> Valley							

T 30 S  
 R 28  
 NE 1/4  
 SW 1/4



**MINTER-WILSON DRILLING CO.** INCORPORATED  
 Irrigation and Domestic Water Systems Complete Installation and Repairing

Phone 276-8269 • P.O. Box 493 • GARDEN CITY, KANSAS 67846

MARK MILLER  
 MEADE COUNTY  
 4-27-76

Location: N.E. 27-30-28  
 From Missler Elevator, 7 miles North, 3½ miles East, ¼ South.

Static Water Level: 125'

Test # 1

0	3	Top Soil
3	40	Brown Sandy Clay
40	52	Brown & White Sandy Clay, Streaks of White Rock
52	70	Fine Sand, Streaks of Clay (20%)
70	81	Brown Clay
81	100	Gray Clay
100	125	Fine Sand, Streaks of Clay (30%)
125	170	Fine to Med. Sand & Fine Gravel (Loose)
170	231	Fine to Med. Sand & Gravel (Loose)
231	256	Brown Sandy Clay
256	259	Hard Streaks
259	293	Fine to Med. Sand & Gravel (Loose) Small Streaks of White Rock
293	317	Gray & Brown Clay
317	360	Fine to Med. Sand & Gravel (Loose)
360	363	Brown Clay & Yellow Clay
363	365	Shale

T.D. 360'