

**WATER WELL RECORD Form WWC-5**


Division of Water Resources App. No.  

Well ID  

Original Record  Correction  Change in Well Use

<b>1 LOCATION OF WATER WELL:</b> County: <b>MEADE</b>	Fraction ¼ NW ¼ NE ¼ NE ¼	Section Number <b>26</b>	Township Number <b>T 30 S</b>	Range Number <b>R 28</b> <input type="checkbox"/> E <input checked="" type="checkbox"/> W
--	------------------------------	-----------------------------	----------------------------------	--

<b>2 WELL OWNER:</b> Last Name: <b>HOOP TRUST</b> First: <b>C/O JIM MCDOWELL</b> Business: <b>HOOP TRUST</b> Address: <b>C/O JIM MCDOWELL</b> Address: <b>29001 C RD</b> City: <b>FWLER</b> State: <b>KS</b> ZIP: <b>67844</b>	Street or Rural Address where well is located (if unknown, distance and direction from nearest town or intersection): If at owner's address, check here: <input type="checkbox"/> <b>8 MILES NORTH OF MEADE</b>
--	--

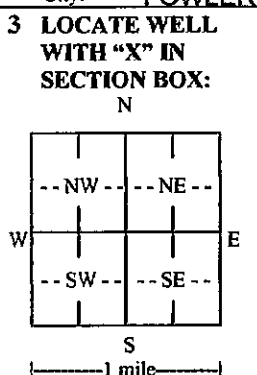

**4 DEPTH OF COMPLETED WELL:** ..... **407** ..... ft.

Depth(s) Groundwater Encountered: 1) ..... ft.  
 2) ..... ft. 3) ..... ft., or 4)  Dry Well

WELL'S STATIC WATER LEVEL: ..... **159** ..... ft.

below land surface, measured on (mo-day-yr).....  
 above land surface, measured on (mo-day-yr).....

Pump test data: Well water was ..... ft.  
 after ..... hours pumping ..... gpm  
 Well water was ..... ft.  
 after ..... hours pumping ..... gpm

Estimated Yield: ..... **50** ..... gpm  
 Bore Hole Diameter: ..... **9.778** ..... in. to ..... ft. and  
 ..... in. to ..... ft.

**5 Latitude:** ..... (decimal degrees)  
**Longitude:** ..... (decimal degrees)  
 Horizontal Datum:  WGS 84  NAD 83  NAD 27  
 Source for Latitude/Longitude:  
 GPS (unit make/model: .....)  
 (WAAS enabled?  Yes  No)  
 Land Survey  Topographic Map  
 Online Mapper: .....

**6 Elevation:** ..... ft.  Ground Level  TOC  
 Source:  Land Survey  GPS  Topographic Map  
 Other .....

**7 WELL WATER TO BE USED AS:**

1. Domestic: <input type="checkbox"/> Household <input type="checkbox"/> Lawn & Garden <input checked="" type="checkbox"/> Livestock 2. <input type="checkbox"/> Irrigation 3. <input type="checkbox"/> Feedlot 4. <input type="checkbox"/> Industrial	5. <input type="checkbox"/> Public Water Supply: well ID ..... 6. <input type="checkbox"/> Dewatering: how many wells? ..... 7. <input type="checkbox"/> Aquifer Recharge: well ID ..... 8. <input type="checkbox"/> Monitoring: well ID ..... 9. Environmental Remediation: well ID ..... <input type="checkbox"/> Air Sparge <input type="checkbox"/> Soil Vapor Extraction <input type="checkbox"/> Recovery <input type="checkbox"/> Injection	10. <input type="checkbox"/> Oil Field Water Supply: lease ..... 11. Test Hole: well ID ..... <input type="checkbox"/> Cased <input type="checkbox"/> Uncased <input type="checkbox"/> Geotechnical 12. Geothermal: how many bores? ..... a) Closed Loop <input type="checkbox"/> Horizontal <input type="checkbox"/> Vertical b) Open Loop <input type="checkbox"/> Surface Discharge <input type="checkbox"/> Inj. of Water 13. <input type="checkbox"/> Other (specify): .....
--	--	---

Was a chemical/bacteriological sample submitted to KDHE?  Yes  No If yes, date sample was submitted: .....

Water well disinfected?  Yes  No

**8 TYPE OF CASING USED:**  Steel  PVC  Other ..... CASING JOINTS:  Glued  Clamped  Welded  Threaded

Casing diameter ..... **5** ..... in. to ..... **407** ..... ft., Diameter ..... in. to ..... ft., Diameter ..... in. to ..... ft.

Casing height above land surface ..... **12** ..... in. Weight ..... **250** ..... lbs./ft. Wall thickness or gauge No. **SDR 17**.....

**TYPE OF SCREEN OR PERFORATION MATERIAL:**

Steel  Stainless Steel  Fiberglass  PVC  Other (Specify) .....

Brass  Galvanized Steel  Concrete tile  None used (open hole)

**SCREEN OR PERFORATION OPENINGS ARE:**

Continuous Slot  Mill Slot  Gauze Wrapped  Torch Cut  Drilled Holes  Other (Specify) .....

Louvered Shutter  Key Punched  Wire Wrapped  Saw Cut  None (Open Hole)

SCREEN-PERFORATED INTERVALS: From **347** ..... ft. to **407** ..... ft., From ..... ft. to ..... ft., From ..... ft. to ..... ft.

GRAVEL PACK INTERVALS: From **25** ..... ft. to **407** ..... ft., From ..... ft. to ..... ft., From ..... ft. to ..... ft.

**9 GROUT MATERIAL:**  Neat cement  Cement grout  Bentonite  Other .....

Grout Intervals: From ..... **5** ..... ft. to **25** ..... ft., From ..... ft. to ..... ft., From ..... ft. to ..... ft.

**Nearest source of possible contamination:**

<input type="checkbox"/> Septic Tank	<input type="checkbox"/> Lateral Lines	<input type="checkbox"/> Pit Privy	<input checked="" type="checkbox"/> Livestock Pens	<input type="checkbox"/> Insecticide Storage
<input type="checkbox"/> Sewer Lines	<input type="checkbox"/> Cess Pool	<input type="checkbox"/> Sewage Lagoon	<input type="checkbox"/> Fuel Storage	<input type="checkbox"/> Abandoned Water Well
<input type="checkbox"/> Watertight Sewer Lines	<input type="checkbox"/> Seepage Pit	<input type="checkbox"/> Feedyard	<input type="checkbox"/> Fertilizer Storage	<input type="checkbox"/> Oil Well/Gas Well
<input type="checkbox"/> Other (Specify) .....				

Direction from well? **SOUTH** ..... Distance from well? **4,000** ..... ft.

10 FROM	TO	LITHOLOGIC LOG	FROM	TO	LITHO. LOG (cont.) or PLUGGING INTERVALS
0	5	TOP SOIL	242	290	MED SAND W/ CLAY STREAKS
5	25	SANDY CLAY	290	318	CLAY W/ SAND STREAKS
25	35	WHITE CLAY	318	372	MED SAND W/ CLAY STREAKS
35	120	BLUE SANDY CLAY	372	398	SANDY CLAY AND SAND STREAKS
120	150	MED SAND AND CLAY	398	407	CLAY W/ SOME SUGAR SAND
150	170	FINE SAND			
170	187	COARSE SAND W/ CLAY STREAKS	Notes: SDR 17 CASING USED FROM 227 TO 407. SDR 21 CASING USED FROM TOP TO 227.		
187	215	CLAY - TIGHT			
215	242	BLUE & GRAY CLAY			

**11 CONTRACTOR'S OR LANDOWNER'S CERTIFICATION:** This water well was  constructed,  reconstructed, or  plugged under my jurisdiction and was completed on (mo-day-year) **4/26/17** ..... and this record is true to the best of my knowledge and belief. Kansas Water Well Contractor's License No. **805** ..... This Water Well Record was completed on (mo-day-year) **5/22/17** ..... under the business name of **SOUTHWEST WINDMILL & WATER WELL**. Signature *[Signature]*