


1 LOCATION OF WATER WELL:	Fraction	Section Number	Township Number	Range Number
County: Meade	NE 1/4 NE 1/4 NW 1/4	30	T 30 S	R 29 <b>(W)</b>

Distance and direction from nearest town or city street address of well if located within city?  
 9 North and 10 1/2 West of Meade, Kansas

2 WATER WELL OWNER: Mr. Al Dierking  
 RR#, St. Address, Box #: Box 235  
 City, State, ZIP Code: Plains, Kansas 67869  
 Board of Agriculture, Division of Water Resources  
 Application Number: ---

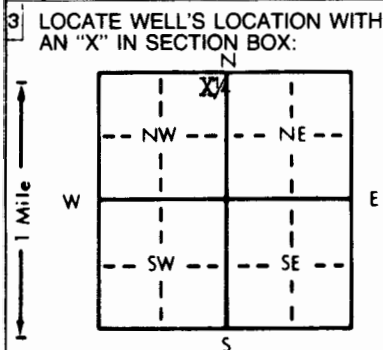

4 DEPTH OF COMPLETED WELL: 380 ft. ELEVATION: Slope

Depth(s) Groundwater Encountered 1. Not available ft. 2. ft. 3. ft.

WELL'S STATIC WATER LEVEL: 192 ft. below land surface measured on mo/day/yr July 29, 1988

Pump test data: Well water was ft. after hours pumping gpm

Est. Yield: 30 gpm: Well water was ft. after hours pumping gpm

Bore Hole Diameter: 10 in. to 380 ft., and in. to ft.

WELL WATER TO BE USED AS:

5 Public water supply	8 Air conditioning	11 Injection well
<input checked="" type="checkbox"/> Domestic	3 Feedlot	6 Oil field water supply
2 Irrigation	4 Industrial	7 Lawn and garden only
		10 Monitoring well
		12 Other (Specify below)

Was a chemical/bacteriological sample submitted to Department? Yes No  If yes, mo/day/yr sample was submitted

Water Well Disinfected? Yes  No

5 TYPE OF BLANK CASING USED:

1 Steel	3 RMP (SR)	6 Asbestos-Cement	9 Other (specify below)
<input checked="" type="checkbox"/> PVC	4 ABS	7 Fiberglass	

CASING JOINTS: Glued  Clamped Welded Threaded

Blank casing diameter: 5 in. to 320 ft., Dia. in. to ft., Dia. in. to ft.

Casing height above land surface: 15 in., weight 2.8 lbs./ft. Wall thickness or gauge No. 265

TYPE OF SCREEN OR PERFORATION MATERIAL:  PVC 10 Asbestos-cement

1 Steel	3 Stainless steel	5 Fiberglass	8 RMP (SR)	11 Other (specify)
2 Brass	4 Galvanized steel	6 Concrete tile	9 ABS	12 None used (open hole)

SCREEN OR PERFORATION OPENINGS ARE:

1 Continuous slot	3 Mill slot	5 Gauzed wrapped	<input checked="" type="checkbox"/> Saw cut	11 None (open hole)
2 Louvered shutter	4 Key punched	6 Wire wrapped	9 Drilled holes	
		7 Torch cut	10 Other (specify)	

SCREEN-PERFORATED INTERVALS: From 320 ft. to 380 ft., From ft. to ft., From ft. to ft.

GRAVEL PACK INTERVALS: From 20 ft. to 380 ft., From ft. to ft., From ft. to ft.

6 GROUT MATERIAL: 1 Neat cement 2 Cement grout 3 Bentonite  Other Baroid Hole Plug

Grout intervals: From 0 ft. to 20 ft., From ft. to ft., From ft. to ft.

What is the nearest source of possible contamination:

<input checked="" type="checkbox"/> Septic tank	4 Lateral lines	7 Pit privy	10 Livestock pens	14 Abandoned water well
2 Sewer lines	5 Cess pool	8 Sewage lagoon	11 Fuel storage	15 Oil well/Gas well
3 Watertight sewer lines	6 Seepage pit	9 Feedyard	12 Fertilizer storage	16 Other (specify below)
			13 Insecticide storage	

Direction from well? West How many feet? 100

FROM	TO	LITHOLOGIC LOG	FROM	TO	PLUGGING INTERVALS
0	2	Topsoil			
2	115	Clay			
115	162	Large Sand			
162	263	Clay			
263	340	Med. Gravel			
340	360	Blue Clay			
360	379	Med. Gravel			
379	380	Black Shale			

7 CONTRACTOR'S OR LANDOWNER'S CERTIFICATION: This water well was (1) constructed, (2) reconstructed, or (3) plugged under my jurisdiction and was completed on (mo/day/year) August 1, 1988 and this record is true to the best of my knowledge and belief. Kansas Water Well Contractor's License No. 252 This Water Well Record was completed on (mo/day/yr) August 24, 1988 under the business name of Friesen Windmill & Supply Inc. by signature *[Signature]*

INSTRUCTIONS: Use typewriter or ball point pen. PLEASE PRESS FIRMLY and PRINT clearly. Please fill in blanks, underline or circle the correct answers. Send top three copies to Kansas Department of Health and Environment, Bureau of Water Protection, Topeka, Kansas 66620-7320. Telephone: 913-296-5514. Send one to WATER WELL OWNER and retain one for your records.

88000002088-70

OFFICE USE ONLY