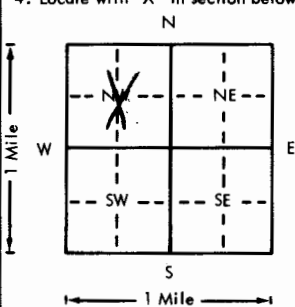


USE TYPEWRITER OR BALL POINT PEN-PRESS FIRMLY, PRINT CLEARLY.

WATER WELL RECORD
KSA 82a-1201-1215

Kansas Department of Health and Environment-Division of Environment
(Water well Contractors)
Topeka, Kansas 66620

1. Location of well:	County MEADE	Fraction SE 1/4 NW 1/4 NW 1/4	Section number 7	Township number T 30 S R 29 E/W	Range number
2. Distance and direction from nearest town or city: South of Copeland Ks. to 2nd Curve 2 South, 3 East. 3/4 North <small>Street address of well location if in city:</small>			3. Owner of well: Ray Rexford R.R. or street: Montezuma, Ks 67867 City, state, zip code:		
4. Locate with "X" in section below: <div style="text-align: center;">  </div>			Sketch map:		
5. Type and color of material			6. Bore hole dia. <u>26</u> in. Completion date <u>12-20-75</u> Well depth <u>170</u> ft.		
			7. <input type="checkbox"/> Cable tool <input type="checkbox"/> Rotary <input type="checkbox"/> Driven <input type="checkbox"/> Dug <input type="checkbox"/> Hollow rod <input type="checkbox"/> Jetted <input type="checkbox"/> Bored <input checked="" type="checkbox"/> Reverse rotary		
			8. Use: <input type="checkbox"/> Domestic <input type="checkbox"/> Public supply <input type="checkbox"/> Industry <input checked="" type="checkbox"/> Irrigation <input type="checkbox"/> Air conditioning <input type="checkbox"/> Stock <input type="checkbox"/> Lawn <input type="checkbox"/> Oil field water <input type="checkbox"/> Other		
			9. Casing: Material <u>Steel</u> Height: Above or below Threaded <input type="checkbox"/> Welded <input checked="" type="checkbox"/> Surface <u>12</u> in. RMP <input type="checkbox"/> PVC <input type="checkbox"/> Weight <u>36.8</u> lbs./ft. Dia. <u>16</u> in. to <u>177</u> ft. depth Wall Thickness: inches or Dia. <u> </u> in. to <u> </u> ft. depth gage No. <u> </u>		
			10. Screen: Manufacturer's name <u> </u> <u>No Screen</u> Type <u> </u> Dia. <u> </u> Slot/gauze <u> </u> Length <u> </u> Set between <u> </u> ft. and <u> </u> ft. Perf. <u>200-180</u> ft. and <u> </u> ft. Gravel pack <u>yes</u> Size range of material <u>1/2" Down</u>		
			11. Static water level: <u> </u> mo./day/yr. <u>176</u> ft. below land surface Date <u>12-28-75</u>		
			12. Pumping level below land surfaces: <u>186</u> ft. after <u>2</u> hrs. pumping <u>776</u> g.p.m. <u>195</u> ft. after <u>4</u> hrs. pumping <u>1250</u> g.p.m. Estimated maximum yield <u>1250</u> g.p.m.		
			13. Water sample submitted: <u> </u> mo./day/yr. <input type="checkbox"/> Yes <input checked="" type="checkbox"/> No Date <u> </u>		
			14. Well head completion: <input type="checkbox"/> Pitless adapter <u>12</u> inches above grade		
			15. Well grouted? <u>yes</u> With: <input checked="" type="checkbox"/> Neat cement <input type="checkbox"/> Bentonite <input type="checkbox"/> Concrete Depth: From <u>0</u> ft. to <u>10</u> ft.		
16. Nearest source of possible contamination: <u>N/A</u> ft. <u> </u> Direction <u> </u> Type <u> </u> Well disinfected upon completion? <input type="checkbox"/> Yes <input checked="" type="checkbox"/> No					
17. Pump: <u>Not installed</u> Manufacturer's name <u>Goulds US Pumps</u> Model number <u>14JHC</u> HP <u>1200</u> Volts <u> </u> Length of drop pipe <u>280</u> ft. capacity <u>1200</u> g.p.m. Type: <input type="checkbox"/> Submersible <input checked="" type="checkbox"/> Turbine <input type="checkbox"/> Jet <input type="checkbox"/> Reciprocating <input type="checkbox"/> Centrifugal <input type="checkbox"/> Other					
(Use a second sheet if needed)					
18. Elevation: Topography: <input type="checkbox"/> Hill <input checked="" type="checkbox"/> Slope <input type="checkbox"/> Upland <input type="checkbox"/> Valley	19. Remarks: Customer furnished gearhead and motor		20. Water well contractor's certification: This well was drilled under my jurisdiction and this report is true to the best of my knowledge and belief. Minter Wilson Drilling 208 Business name <u> </u> License No. <u> </u> Address <u>P.O. Box 4 Garden City, Ks</u> Signature <u>[Signature]</u> Date <u>6-30-75</u> Authorized representative		

T 30 S R 29 E
 Sec 7
 SE 1/4 NW 1/4

Surface
meals

MINTER-WILSON DRILLING CO.
INCORPORATED

Irrigation
and Domestic
Water Systems
Complete Installation
and Repairing

Phone 276-8269 • P.O. Box 493 • GARDEN CITY, KANSAS 67846

Ray Rexford
Meade County
10-29-75

Location: NW 7-30-29
2 miles West of Chester's house, 3/4 North

0	3	Top Soil
3	52	Brown Sandy Clay
52	95	Fine Sand, Streaks of Clay (20%)
95	112	Brown Sandy Clay
112	312	Fine to Med. Sand & Gravel (Loose)
312	321	Fine to Med. Sand & Gravel (Little Tight)
321	395	Fine to Med. Sand & Gravel (Loose)
395	412	Fine to Med. Sand & Gravel, Streaks of White Rock & Clay (10%)
412	470	Fine to Med. Sand & Gravel (Loose)
470	480	Fine Sand & Clay, White Rock (Mixed)

TD 470