

USE TYPEWRITER OR BALL POINT PEN-PRESS FIRMLY, PRINT CLEARLY.

T R EW sec 1/4 1/4 1/4 No.

WATER WELL RECORD
KSA 82a-1201-1215


Kansas State Dept. Of Health
(Water Well Contractors)
Forbes-Bldg. 740
Topeka, Kansas 66620

Schmidt #1

CWW Inv. #11258

1 Location of well:	County Meade	Township name	Fraction SW SE	Section number 20	Town number 30S	Range number 29W
---------------------	------------------------	---------------	--------------------------	-----------------------------	---------------------------	----------------------------

Distance and direction from nearest town or city: 5 Mi. East on Hwy 54, 9 Mi. North, & 1/4 West to Loc.	3 Owner of well: Rine Drilling Co. Suite 600 Address: 300 W. Douglas Wichita, Kansas 67202
--	---

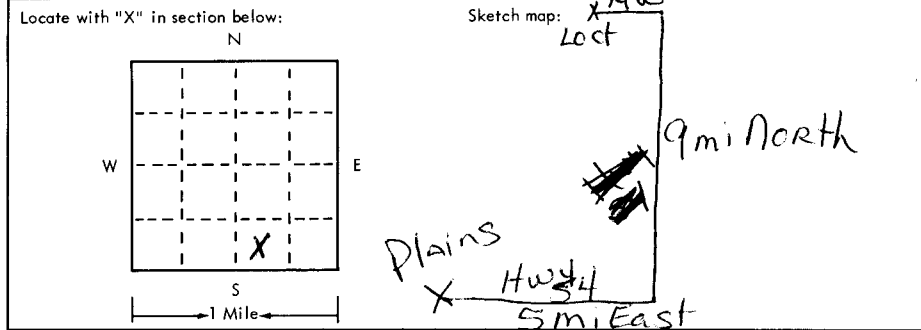

4 Well depth: 240 ft. Date of completion 4/25/75
Well diameter 9 in.

5 Cable tool Rotary Driven Dug
 Hollow rod Jetted Bored Reverse rotary

6 Use: Domestic Public supply Industry
 Irrigation Air conditioning Commercial
 Test well Oil Well

7 Casing: Material PVC Height: above/below
Threaded Welded Surface 18 in.
Diam. 2.78 lbs./ft.
5 1/2 in. to 180 ft. depth Drive shoe? Yes No
2 1/2 in. to 240 ft. depth

2	Type and color of material	From	To
	Surface	0	2
	Clay	2	22
	Fine Sand	22	81
	Sandy Clay	81	114
	Fine to Med. Sand & Gravel	114	240
<p><i>This Water Well Given to Dale Schmidt of Montezuma, Kansas by Rine DRLG Co. by written com. received from L.B. McCave on 5/28/75. 5/28/75 DAB</i></p>			
(use a second sheet if needed)			

8 Screen:
Manufacturer None
Type None Dia. None
Slot/gauze None Length None
Set between None ft. and None ft.
Fittings:
Gravel pack Yes No Size range of material None

9 Static water level:
148 ft. below land surface Date 4/25/75

10 Pumping level below land surfaces:
None ft. after None hrs. pumping None g.p.m.
None ft. after None hrs. pumping None g.p.m.
Estimated maximum yield 60 g.p.m.

11 Water sample submitted:
 Yes No Date None

12 Well head completion:
 Pitless adapter 18 inches above grade

13 Well grouted? Yes No
 Neat cement Bentonite None
Depth: From 0 ft. to 10 ft.

14 Nearest source of possible contamination:
ft. 100 Direction SW Type Oil Well
Well disinfected upon completion? Yes No

15 Pump: Not installed
Manufacturer's name None
Model number None HP None Volts None
Length of drop pipe None ft. capacity None g.m.p.
Type:
 Submersible Turbine
 Jet Reciprocating
 Centrifugal Other

16 Remarks: elevation

Topography:
 Hill
 Slope
 Upland
 Valley

17 Water well contractor's certification:
This well was drilled under my jurisdiction and this report is true to the best of my knowledge and belief.
Carlile Water Well 118
Business name Carlile Water Well License No. 118
Address Box 275, Liberal, Ks. 67901
Signed Edward P. Means Date 5/1/75
Authorized representative