USE TYPEWRITER OR BALL POINT PEN-PRESS FIRMLY, PRINT CLEARLY.

WATER WELL RECORD
KSA 82a-1201-1215

Kansas Department of Health and Environment-Division of Environment
(Water well Contractors)
Topeka, Kansas 66620

1. Location of well:	County	Fraction	Section number	Township number	Range number
	Meade	NW 1/4 NW 1/4 SE 1/4	30	T 30 S	R 29 E/W

2. Distance and direction from nearest town or city: 4½M S, 2E, 4S, 3E, ½S, ½ E of Copeland, Kansas
Street address of well location if in city:

3. Owner of well: Mrs Gano Pearson
R.R. or street: % Stanley Smith
City, state, zip code: 1st National Bank of Hutchinson P.O. Box 1, Garden City, Kansas 67846

4. Locate with "X" in section below: Sketch map:

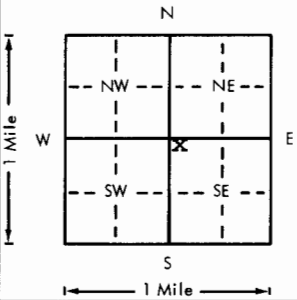

NW corner of the SE¼, Sec 30, T30S, R29W, Meade County, Kansas

6. Bore hole dia. 28 in. Completion date 12-20-76
Well depth 368 ft.

7. __ Cable tool __ Rotary __ Driven __ Dug __ Hollow rod __ Jetted __ Bored X Reverse rotary

8. Use: __ Domestic __ Public supply __ Industry X Irrigation __ Air conditioning __ Stock __ Lawn __ Oil field water __ Other

9. Casing: Material Stl Height: Above or below
Threaded ___ Welded X Surface 12 in.
RMP ___ PVC ___ Weight 37 lbs./ft.
Dia. 16 in. to 208 ft. depth Wall Thickness: inches or
Dia. ___ in. to ___ ft. depth gage No. 219

5. Type and color of material	From	To
Top soil	0	6
Tan clay	6	51
Fine to medium sand clay streaks	51	80
Fine to coarse sand fine to medium gravel	80	172
Tan clay	172	178
Fine to coarse sand small clay streaks	178	286
Blue clay	286	302
Fine to coarse sand clay tan streaks	302	368
Tan clay caliche streaks	368	420
(Use a second sheet if needed)		

10. Screen: Manufacturer's name Foster Doerr
Type Louvered, Millslot 16"
Slot/gauze 1/8" Length 160
Set between 208 ft. and 368 ft.
___ ft. and ___ ft.
Gravel pack? X Size range of material 3 4 mm

11. Static water level: mo./day/yr.
162 ft. below land surface Date 9-9-76

12. Pumping level below land surfaces:
198 ft. after ½ hrs. pumping 2048 g.p.m.
208 ft. after 1 hrs. pumping 2286 g.p.m.
Estimated maximum yield 2300 g.p.m.

13. Water sample submitted: mo./day/yr.
__ Yes X No Date ___

14. Well head completion:
__ Pitless adapter X Inches above grade

15. Well grouted? Yes
With: __ Neat cement X Bentonite __ Concrete
Depth: From 0 ft. to 10 ft.

16. Nearest source of possible contamination: Unk
ft. ___ Direction ___ Type ___
Well disinfected upon completion? X Yes __ No

17. Pump: __ Not installed
Manufacturer's name Layne & Bowler
Model number 14TL HP 200 Volts ___
Length of drop pipe 260 ft. capacity 2000 g.p.m.
Type:
__ Submersible X Turbine
__ Jet __ Reciprocating
__ Centrifugal __ Other

18. Elevation:
Topography:
__ Hill
__ Slope
X Upland
__ Valley

19. Remarks:

20. Water well contractor's certification:
This well was drilled under my jurisdiction and this report is true to the best of my knowledge and belief.
Layne-Western Company, Inc
Business name License No. 102
Address Garden City, Kansas
Signed [signature] Date 10 Jan 77
Authorized representative

T 30 R 29 (W) Sec 30 1/4 1/4 1/4 NWNSE

Forward the white, blue and pink copies to the Department of Health and Environment

Form WWC-5

MI-1023