


WATER WELL RECORD

Form WWC-5

Division of Water Resources App. No. _____

1 LOCATION OF WATER WELL: County: <u>Meade</u> Street/Rural Address of Well Location; if unknown, distance & direction from nearest town or intersection: If at owner's address, check here <input checked="" type="checkbox"/>	Fraction <u>1/4 NW 1/4 NW 1/4 SW 1/4</u> Section Number <u>8</u> Township No. <u>T 30 S</u> Range Number <u>R 29</u> <input type="checkbox"/> E <input checked="" type="checkbox"/> W	Global Positioning System (GPS) information: Latitude: (in decimal degrees) Longitude: (in decimal degrees) Elevation: Datum: <input type="checkbox"/> WGS 84, <input type="checkbox"/> NAD 83, <input type="checkbox"/> NAD 27 Collection Method: <input type="checkbox"/> GPS unit (Make/Model:) <input type="checkbox"/> Digital Map/Photo, <input type="checkbox"/> Topographic Map, <input type="checkbox"/> Land Survey Est. Accuracy: <input type="checkbox"/> <3 m, <input type="checkbox"/> 3-5 m, <input type="checkbox"/> 5-15 m, <input type="checkbox"/> >15 m
2 WATER WELL OWNER: RR#, Street Address, Box #: <u>Clark Jantz</u> <u>2137 8 Rd.</u> City, State, ZIP Code: <u>Montezuma, Ks. 67867</u>		

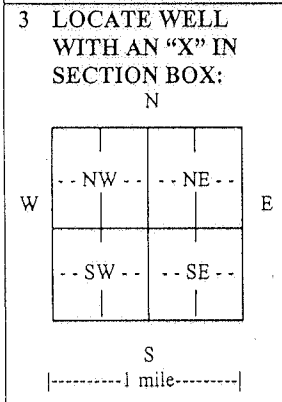

4 DEPTH OF COMPLETED WELL 495 ft.

Depth(s) Groundwater Encountered (1)..... ft. (2)..... ft. (3)..... ft.

WELL'S STATIC WATER LEVEL..... 280 ft. below land surface measured on mo/day/yr. 6/24/13

Pump test data: Well water was ft. after hours pumping gpm

EST. YIELD..... gpm. Well water was ft. after hours pumping gpm

Bore Hole Diameter 7 7/8 in. to 4 9/5 ft., and in. to ft.

WELL WATER TO BE USED AS: Public water supply Geothermal Injection well
 Domestic Feedlot Oil field water supply Dewatering Other (Specify below)
 Irrigation Industrial Domestic-lawn & garden Monitoring well

Was a chemical/bacteriological sample submitted to Department? Yes No

If yes, mo/day/yr sample was submitted.....

Water well disinfected? Yes No

5 TYPE OF CASING USED: Steel PVC Other

CASING JOINTS: Glued Clamped Welded Threaded

Casing diameter 5 in. to 4 9/5 ft., Diameter in. to ft., Diameter in. to ft.

Casing height above land surface..... 12 in., Weight lbs./ft., Wall thickness or gauge No. SDR21

TYPE OF SCREEN OR PERFORATION MATERIAL:

Steel Stainless Steel PVC Other (Specify)

Brass Galvanized Steel None used (open hole)

SCREEN OR PERFORATION OPENINGS ARE:

Continuous slot Mill slot Gauze wrapped Torch cut Drilled holes None (open hole)
 Louvered shutter Key punched Wire wrapped Saw cut Other (specify)

SCREEN-PERFORATED INTERVALS: From..... 395 ft. to 495 ft., From ft. to

GRAVEL PACK INTERVALS: From..... 24 ft. to 495 ft., From ft. to

6 GROUT MATERIAL: Neat cement Cement grout Bentonite Other

Grout Intervals: From..... 7 ft. to 24 ft., From ft. to ft., From ft. to

What is the nearest source of possible contamination:

Septic tank Lateral lines Pit privy Livestock pens Insecticide storage Other (specify below)
 Sewer lines Cesspool Sewage lagoon Fuel storage Abandoned water well
 Watertight sewer lines Seepage pit Feedyard Fertilizer storage Oil well/gas well None Observed

Direction from well Distance from well

FROM	TO	LITHOLOGIC LOG	FROM	TO	LITHO. LOG (cont.) or PLUGGING INTERVAL
0	50	Tan clay & Caliche	400	415	Tan Sandy clay & Med. Sand
50	80	Red Sandy clay	415	495	Med. Sand & brown Sandy clay
80	240	Med. Sand			
240	280	Med. Sand & blue clay layers			
280	340	Med. Sand			
340	360	Med. to Course Sand			
360	365	Blue clay			
365	386	Course Sand			
386	392	Tan Clay			
392	400	Course Sand			

7 CONTRACTOR'S OR LANDOWNER'S CERTIFICATION: This water well was constructed, reconstructed, or plugged under my jurisdiction and was completed on (mo/day/year) ... 6/24/13, and this record is true to the best of my knowledge and belief

Kansas Water Well Contractor's License No. 533 This Water Well Record was completed on (mo/day/year) 11/4/14

under the business name of: Jantz Water Well by (signature)

INSTRUCTIONS: Use typewriter or ball point pen. PLEASE PRESS FIRMLY and PRINT clearly. Please fill in blanks and check the correct answers. Send three co (white, blue, pink) to Kansas Department of Health and Environment, Bureau of Water, Geology Section, 1000 SW Jackson St., Suite 420, Topeka, Kansas 66612-1. Telephone 785-296-5524. Send one copy to WATER WELL OWNER and retain one for your records. Include fee of \$5.00 for each constructed well. Visit u <http://www.kdheks.gov/waterwell/index.html>.