

WATER WELL RECORD Form WWC-5 1234660


Original Record Correction Change in Well Use

Division of Water Resources App. No.

Well ID

1 LOCATION OF WATER WELL: County: Fraction Section Number Township Number Range Number

2 WELL OWNER: Last Name: Business: Address: City: State: ZIP: Street or Rural Address where well is located

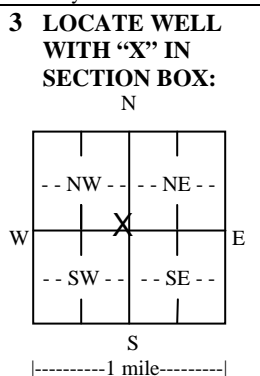

4 DEPTH OF COMPLETED WELL: Depth(s) Groundwater Encountered: WELL'S STATIC WATER LEVEL: Pump test data: Estimated Yield: Bore Hole Diameter:

5 Latitude: Longitude: Datum: Source for Latitude/Longitude: 6 Elevation: Source:

7 WELL WATER TO BE USED AS: 1. Domestic: 2. Irrigation: 3. Feedlot: 4. Industrial: 5. Public Water Supply: 6. Dewatering: 7. Aquifer Recharge: 8. Monitoring: 9. Environmental Remediation: 10. Oil Field Water Supply: 11. Test Hole: 12. Geothermal: 13. Other

Was a chemical/bacteriological sample submitted to KDHE? Water well disinfected?

8 TYPE OF CASING USED: CASING JOINTS: TYPE OF SCREEN OR PERFORATION MATERIAL: SCREEN OR PERFORATION OPENINGS ARE: SCREEN-PERFORATED INTERVALS: GRAVEL PACK INTERVALS:

9 GROUT MATERIAL: Grout Intervals: Nearest source of possible contamination: Direction from well? Distance from well?

Table with columns: FROM, TO, LITHOLOGIC LOG, FROM, TO, LITHO. LOG (cont.) or PLUGGING INTERVALS. Includes a Notes section.

11 CONTRACTOR'S OR LANDOWNER'S CERTIFICATION: This water well was constructed, reconstructed, or plugged under my jurisdiction and was completed on (mo-day-year) and this record is true to the best of my knowledge and belief.

| | |
|------------|-------------------------------------|
| Form | WWC5 |
| Contractor | Hydro Resources Mid Continent, Inc. |
| Well Owner | |
| Doc ID | 1234660 |

Litholgy

| From | To | LithologicLog |
|------|-----|------------------------------------|
| 0 | 2 | surface |
| 2 | 32 | brown clay, caliche |
| 32 | 46 | sandy brown clay |
| 46 | 93 | sand fine thin clays |
| 93 | 112 | sand fine med coarse |
| 112 | 124 | brown clay |
| 124 | 412 | sand fine to med coarse |
| 412 | 418 | sand fine to small |
| 418 | 445 | sand fine med coarse |
| 445 | 458 | sand fine to med |
| 458 | 462 | gray clay, yellow, white sandstone |
| 462 | 501 | sand fine |
| 501 | 524 | sand fine to small |
| 524 | 551 | gray clay, white yellow soapstone |
| 551 | 575 | gray soapstone |
| 575 | 620 | red bed |