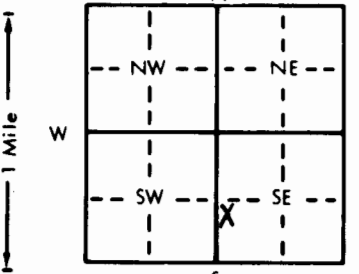


1 LOCATION OF WATER WELL:		Fraction		Section Number	Township Number	Range Number
County: SUMNER		NW 1/4 SW 1/4 SE 1/4		29	T 30 S	R 3 W E/W
Distance and direction from nearest town or city street address of well if located within city? 1/2 N. of Conway Springs, 1 1/2 W., 1/2 N. & 330' E. into location CONWAY SPRINGS, KS.						
2 WATER WELL OWNER: Herman Hemberger						
RR#, St. Address, Box #: 318 S. 7						
City, State, ZIP Code: Conway Springs, Ks.						
Board of Agriculture, Division of Water Resources						
Application Number:						
3 LOCATE WELL'S LOCATION WITH AN "X" IN SECTION BOX:		4 DEPTH OF COMPLETED WELL: 100 ft. ELEVATION:				
		Depth(s) Groundwater Encountered 1. 15 ft. 2. ft. 3. ft.				
		WELL'S STATIC WATER LEVEL 15 ft. below land surface measured on mo/day/yr 8-13-82				
		Pump test data: Well water was ft. after hours pumping gpm				
		Est. Yield gpm: Well water was ft. after hours pumping gpm				
		Bore Hole Diameter 12 in. to ft. and in. to ft.				
		WELL WATER TO BE USED AS: 5 Public water supply 8 Air conditioning 11 Injection well				
		1 Domestic 3 Feedlot 6 Oil field water supply 9 Dewatering 12 Other (Specify below)				
		2 Irrigation 4 Industrial 7 Lawn and garden only 10 Observation well				
		Was a chemical/bacteriological sample submitted to Department? Yes No X; If yes, mo/day/yr sample was submitted				
		Water Well Disinfected? Yes X No				
5 TYPE OF BLANK CASING USED:						
1 Steel 3 RMP (SR) 5 Wrought iron 8 Concrete tile CASING JOINTS: Glued X Clamped						
2 PVC 4 ABS 6 Asbestos-Cement 9 Other (specify below) Welded						
7 Fiberglass Threaded						
Blank casing diameter 5 in. to 20 ft. Dia in. to ft. Dia in. to ft.						
Casing height above land surface 12 in. weight 1.59 lbs./ft. Wall thickness or gauge No. .203						
Cer-mac Styrene SDR-26						
TYPE OF SCREEN OR PERFORATION MATERIAL:						
1 Steel 3 Stainless steel 5 Fiberglass 7 PVC 10 Asbestos-cement						
2 Brass 4 Galvanized steel 6 Concrete tile 8 RMP (SR) 11 Other (specify)						
9 ABS 12 None used (open hole)						
SCREEN OR PERFORATION OPENINGS ARE:						
1 Continuous slot 5 Gauzed wrapped 8 Saw cut 11 None (open hole)						
2 Louvered shutter 3 Mill slot 6 Wire wrapped 9 Drilled holes						
4 Key punched 7 Torch cut 10 Other (specify)						
SCREEN-PERFORATED INTERVALS: From 20 ft. to 100 ft. From ft. to ft.						
From ft. to ft. From ft. to ft.						
GRAVEL PACK INTERVALS: From 14 ft. to 100 ft. From ft. to ft.						
From ft. to ft. From ft. to ft.						
6 GROUT MATERIAL: 1 Neat cement 2 Cement grout 3 Bentonite 4 Other						
Grout Intervals: From 4 ft. to 14 ft. From ft. to ft. From ft. to ft.						
What is the nearest source of possible contamination:						
1 Septic tank 4 Lateral lines 7 Pit privy 10 Livestock pens 14 Abandoned water well						
2 Sewer lines 5 Cess pool 8 Sewage lagoon 11 Fuel storage 15 Oil well/Gas well						
3 Watertight sewer lines 6 Seepage pit 9 Feedyard 12 Fertilizer storage 16 Other (specify below)						
13 Insecticide storage NONE APPARENT						
Direction from well? How many feet?						
FROM TO LITHOLOGIC LOG FROM TO LITHOLOGIC LOG						
0 3 Topsoil						
3 100 Red Shale						
CONTRACTOR'S OR LANDOWNER'S CERTIFICATION: This water well was (1) constructed, (2) reconstructed, or (3) plugged under my jurisdiction and was completed on (mo/day/year) 8-13-82 and this record is true to the best of my knowledge and belief. Kansas						
Water Well Contractor's License No. 236 This Water Well Record was completed on (mo/day/yr) 10-15-82						
under the business name of Harp Well & Pump Serv., Inc. by (signature) M. Arnold						
INSTRUCTIONS: Use typewriter or ball point pen, PLEASE PRESS FIRMLY and PRINT clearly. Please fill in blanks, underline or circle the correct answers. Send top three copies to Kansas Department of Health and Environment, Division of Environment, Environmental Geology Section, Topeka, KS 66620. Send one to WATER WELL OWNER and retain one for your records.						