

1 LOCATION OF WATER WELL: County: <u>SUMNER</u>	Fraction <u>SE 1/4 SE 1/4 SE 1/4</u>	Section Number <u>33</u>	Township Number T <u>30</u> S	Range Number R <u>3</u> E <u>(W)</u>
--	---	-----------------------------	----------------------------------	---

Distance and direction from nearest town or city street address of well if located within city?


CONWAY SPRINGS KS

2 WATER WELL OWNER: USAC I
RR#, St. Address, Box #: 5665 FLAT IRON PARKWAY
City, State, ZIP Code: BOULDER KS 80301

MW-1
Board of Agriculture, Division of Water Resources
Application Number: _____

3 LOCATE WELL'S LOCATION WITH AN "X" IN SECTION BOX:

4 DEPTH OF COMPLETED WELL.....15..... ft. ELEVATION:

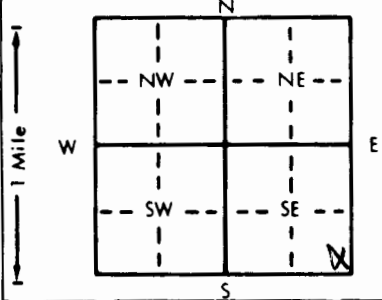

Depth(s) Groundwater Encountered 1. ft. 2. ft. 3. ft.

WELL'S STATIC WATER LEVEL 10 ft. below land surface measured on mo/day/yr

Pump test data: Well water was ft. after hours pumping gpm

Est. Yield gpm: Well water was ft. after hours pumping gpm

Bore Hole Diameter 8 in. to 15 ft., and in. to ft.

WELL WATER TO BE USED AS:

5 Public water supply	8 Air conditioning	11 Injection well		
1 Domestic	3 Feedlot	6 Oil field water supply	9 Dewatering	12 Other (Specify below)
2 Irrigation	4 Industrial	7 Lawn and garden only	10 Monitoring well	

Was a chemical/bacteriological sample submitted to Department? Yes No ☒ If yes, mo/day/yr sample was submitted

Water Well Disinfected? Yes No ☒

5	TYPE OF BLANK CASING USED:
---	----------------------------

5 Wrought iron 8 Concrete tile CASING JOINTS: Glued Clamped

Blank casing diameter 2 in. to 5 ft. Dia. Welded
Casing height above land surface 0 in., weight _____ lbs./ft. Wall thickness or gauge No. _____
1 Steel 3 RMP (SR) 6 Asbestos-Cement 9 Other (specify below) Threaded
2 PVC 4 ABS 7 Fiberglass

TYPE OF SCREEN OR PERFORATION MATERIAL:

1 Steel	3 Stainless steel	5 Fiberglass	8 RMP (SR)	11 Other (specify)
2 Brass	4 Galvanized steel	6 Concrete tile	9 ABS	12 None used (open hole)

SCREEN OR PERFORATION OPENINGS ARE:

1 Continuous slot 3 Mill slot 6 Wire wrapped 9 Drilled holes
2 Louvered shutter 4 Key punched 7 Torch cut 10 Other (specify)

SCREEN-PERFORATED INTERVALS: From 5 ft. to 15 ft., From _____ ft. to _____ ft.

GRAVEL PACK INTERVALS:

From	ft. to	ft.	From	ft. to	ft.
From	ft. to	ft.	From	ft. to	ft.
From	ft. to	ft.	From	ft. to	ft.

6 GROUT MATERIAL: 1 Neat cement 2 Cement grout 3 Bentonite 4 Other

What is the nearest source of possible contamination:

1 Septic tank	4 Lateral lines	7 Pit privy	11 Fuel storage	15 Oil well/Gas well
2 Sewer lines	5 Cess pool	8 Sewage lagoon	12 Fertilizer storage	16 Other (specify below)
3 Watertight sewer lines	6 Seepage pit	9 Feedyard	13 Insecticide storage

Direction from well?

FROM	TO	LITHOLOGIC LOG	FROM	TO	PLUGGING INTERVALS
------	----	----------------	------	----	--------------------

C	TA Delta Chan, xchile			
---	-----------------------	--	--	--

[illegible][illegible][illegible]

5/8/91 approval obtained

3/6/91 approval obtained

[illegible]

1	2	
---	---	---	---	---	---	---	---	---	----	----	-----	-----	

[illegible][illegible][illegible][illegible]

1	2	
---	---	---	---	---	---	---	---	---	----	----	-----




7] CONTRACTOR'S OR LANDOWNER'S CERTIFICATION: This water well was (1) constructed, (2) reconstructed, or (3) plugged under my jurisdiction and was

completed on (mo/day/year) 6/6/10 and this record is true to the best of my knowledge and belief. Kansas

Water Well Contractor's License No. 102 This Water Well Record was completed on (mo/day/yr) 7/16/91

under the business name of Jaune Nielsen by (signature) JM Nielsen

INSTRUCTIONS: Use typewriter or ball point pen. PLEASE PRESS FIRMLY and PRINT clearly. Please fill in blanks, underline or circle the correct answers. Send top three copies to Kansas Department

of Health and Environment, Bureau of Water, Topeka, Kansas 66620-7320. Telephone: 913-296-5545. Send one to WATER WELL OWNER and retain one for your records.

