


WATER WELL RECORD Form WWC-5 KSA 82a-1212

1 LOCATION OF WATER WELL: County: Meade Fraction NW 1/4 SE 1/4 NW 1/4 Section Number 14 Township Number T 30 S Range Number R 30 E/W

Distance and direction from nearest town or city street address of well if located within city?
4 Mile South 2 Mile East 2 Miles South 1 Mile East 1/4 South 1/4 East of Copeland

2 WATER WELL OWNER: Mr. Jeff Corbin
 RR#, St. Address, Box # : 919 N. Stratford Board of Agriculture, Division of Water Resources
 City, State, ZIP Code : Wichita, Kansas 67206 Application Number: 17768

3 LOCATE WELL'S LOCATION WITH AN "X" IN SECTION BOX:

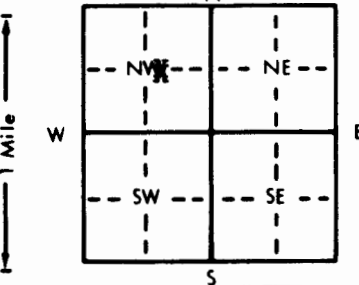

4 DEPTH OF COMPLETED WELL: 362 ft. ELEVATION:
 Depth(s) Groundwater Encountered 1. 221 - 355 ft. 2. 360-362 ft. 3. ft.
 WELL'S STATIC WATER LEVEL 220 ft. below land surface measured on mo/day/yr 5-18-91
 Pump test data: Well water was ft. after hours pumping gpm
 Est. Yield 1500 gpm: Well water was ft. after hours pumping gpm
 Bore Hole Diameter 26 in. to 362 ft., and in. to ft.
 WELL WATER TO BE USED AS: 5 Public water supply 8 Air conditioning 11 Injection well
 1 Domestic 3 Feedlot 6 Oil field water supply 9 Dewatering 12 Other (Specify below)
 2 Irrigation 4 Industrial 7 Lawn and garden only 10 Monitoring well
 Was a chemical/bacteriological sample submitted to Department? Yes.....No. X.....; If yes, mo/day/yr sample was sub-
 mitted Water Well Disinfected? Yes X No

5 TYPE OF BLANK CASING USED: 1 Steel 3 RMP (SR) 5 Wrought iron 8 Concrete tile CASING JOINTS: Glued Clamped
 2 PVC 4 ABS 6 Asbestos-Cement 9 Other (specify below) Welded
 7 Fiberglass Threaded riveted

Blank casing diameter 16" in. to 282 ft., Dia in. to ft., Dia in. to ft.
 Casing height above land surface 12 in., weight lbs./ft. Wall thickness or gauge No. SCH 240

TYPE OF SCREEN OR PERFORATION MATERIAL: 1 Steel 3 Stainless steel 5 Fiberglass 8 RMP (SR) 11 Other (specify)
 2 Brass 4 Galvanized steel 6 Concrete tile 9 ABS 12 None used (open hole)

SCREEN OR PERFORATION OPENINGS ARE: 1 Continuous slot 3 Mill slot 5 Gauzed wrapped 8 Saw cut 11 None (open hole)
 2 Louvered shutter 4 Key punched 6 Wire wrapped 9 Drilled holes
 7 Torch cut 10 Other (specify)

SCREEN-PERFORATED INTERVALS: From 282 ft. to 362 ft., From ft. to ft.
 GRAVEL PACK INTERVALS: From 20 ft. to 362 ft., From ft. to ft.

6 GROUT MATERIAL: 1 Neat cement 2 Cement grout 3 Bentonite 4 Other

Grout Intervals: From 0 ft. to 20 ft., From ft. to ft., From ft. to ft.
 What is the nearest source of possible contamination:
 1 Septic tank 4 Lateral lines 7 Pit privy 10 Livestock pens 14 Abandoned water well
 2 Sewer lines 5 Cess pool 8 Sewage lagoon 11 Fuel storage 15 Oil well/Gas well
 3 Watertight sewer lines 6 Seepage pit 9 Feedyard 12 Fertilizer storage 16 Other (specify below)
 13 Insecticide storage

Direction from well? 225' East How many feet?

FROM	TO	LITHOLOGIC LOG	FROM	TO	PLUGGING INTERVALS
0	15	Topsoil	240	255	Sand
15	60	Clay & little lime	255	270	Sand (little fine)
60	70	Clay, little lime & little fine sand	270	285	Sand (little fine & 3' clay)
70	105	Sand & clay	285	330	Fine sand w/ some clay
105	113	Sand, clay & cemented sand	330	355	Sand & clay & fine sand
113	120	Cemented sand (hard) & clay	355	360	Clay
120	135	Sand & clay & little cemented sand	360	367	Sand, clay & fine sand
135	150	Sand & clay	367	368	Lime (hard)
150	158	Clay	368	382	Clay & little lime
158	165	Sand	382	384	Lime very hard
165	177	Sand & 2' clay	384	390	Clay & lime hard
177	183	Clay	390	405	Clay (blue) & little lime (hard)
183	195	Sand & 1' clay			
195	225	Sand			
225	240	Sand & 1' clay			

7 CONTRACTOR'S OR LANDOWNER'S CERTIFICATION: This water well was (1) constructed, (2) reconstructed, or (3) plugged under my jurisdiction and was completed on (mo/day/year) May 21, 1991 and this record is true to the best of my knowledge and belief. Kansas Water Well Contractor's License No. 223 This Water Well Record was completed on (mo/day/yr) May 31, 1991 under the business name of Dunham Drilling Company by (signature) [Signature]

INSTRUCTIONS: Use typewriter or ball point pen. PLEASE PRESS FIRMLY and PRINT clearly. Please fill in blanks, underline or circle the correct answers. Send top three copies to Kansas Department of Health and Environment, Bureau of Water, Topeka, Kansas 66620-7320. Telephone: 913-296-5545. Send one to WATER WELL OWNER and retain one for your records.