


WATER WELL RECORD Form WWC-5 KSA 82a-1212

1 LOCATION OF WATER WELL: Fraction Section Number Township Number Range Number
 COUNTY: 060 MEADE 1/4 NE 1/4 31 T 30 S R 30 W

Distance and direction from nearest town or city street address of well if located within city?
 APPROX. 8 3/4 NORTH, & 2 1/4 MILES WEST OF PLAINS

2 WATER WELL OWNER: HULBURT, PAULINE Board of Agriculture, Division of Water Resources
 RR#, St. Address, Box #: 115 DELLWOOD Application Number: 33,565
 City, State, ZIP code: ATHENS, KS 67864-

3 LOCATE WELL'S LOCATION WITH AN "X" IN SECTION BOX: 4 DEPTH OF COMPLETED WELL 390 ELEVATION: 0
 Depth(s) Groundwater Encountered 1. 0 ft. 2. 0 ft. 3. 0 ft.

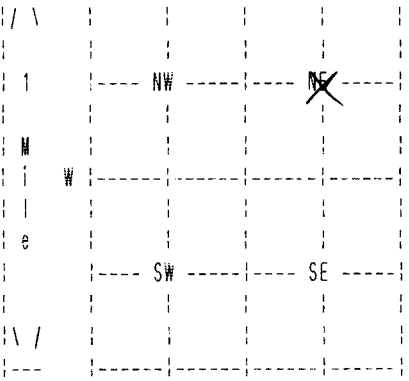

WELL'S STATIC WATER LEVEL 241 ft. below land surface measured on mo/day/yr 05/02/95
 Pump test data: Well water was 0 ft. after 0 hours pumping 0 gpm
 Estimated Yield 0 gpm: Well water was 0 ft. after 0 hours pumping 0 gpm
 Bore Hole Diameter in. to 0 ft., and in. to 0 ft.
 WELL WATER WAS: 02 IRRIGATION
 Was a chemical/bacteriological sample submitted to department? No;
 If yes, mo/day/yr sample was submitted Water well disinfected? Yes!

5 TYPE OF BLANK CASING USED: 01 STEEL CASING JOINTS: WELDED
 Blank casing diameter 16 in. to 390 ft., Dia in. to 0 ft., Dia in. to 0 ft.
 Casing height above land surface -48 in., weight 0 lbs/ft. Wall thickness or gauge No.
 TYPE OF SCREEN OR PERFORATION MATERIAL: 01 STEEL
 SCREEN OR PERFORATION OPENINGS ARE: UNKNOWN

SCREEN PERFORATED INTERVALS: From 0 ft. to 0 ft., From 0 ft. to 0 ft.
 From 0 ft. to 0 ft., From 0 ft. to 0 ft.
 GRAVEL PACK INTERVALS: From 0 ft. to 0 ft., From 0 ft. to 0 ft.
 From 0 ft. to 0 ft., From 0 ft. to 0 ft.

6 GROUT MATERIAL 02 CEMENT GROUT
 Grout intervals: From 4 ft. to 22 ft., From 0 ft. to 0 ft., From 0 ft. to 0 ft.
 What is the nearest source of possible contamination: NONE OBSERVED
 Direction from well? How many feet? 0

FROM	TO	LITHOLOGIC LOG	FROM	TO	PLUGGING INTERVALS
			0	4	BACKFILL
			4	22	CEMENT GROUT
			22	211	CLAY
			211	390	SAND & GRAVEL
			0	0	
			0	0	
			0	0	
			0	0	
			0	0	
			0	0	

7 CONTRACTOR'S OR LANDOWNER'S CERTIFICATION: This water well was Plugged under my jurisdiction and was completed on (mo/day/year) 05/02/95 and this record is true to the best of my knowledge and belief. Kansas Water Well Contractor's License No. 145 This Water Well Record was completed on (mo/day/yr) 05/23/95 under the business name of HENKLE DRILLING & SUPPLY by (signature) *Bruce Richmond*