

WATER WELL RECORD
KSA 82a-1201-1215

T R EW sec 1/4 1/4 1/4 No.


Kansas State Dept. Of Health
(Water Well Contractors)
Forbes-Bldg. 740
Topeka, Kansas 66620

Location of well	Township name Haskell	Fraction NE$\frac{1}{4}$	Section number 24	Town number 30	Range number 31
------------------	---------------------------------	---	-----------------------------	--------------------------	---------------------------

Distance and direction from nearest town or city: **1 Mile West and 7 South of Copeland**

Street address of well location if in city:

3 Owner of well: **C. S. Sommerville**
Address: **Copeland, Kansas**

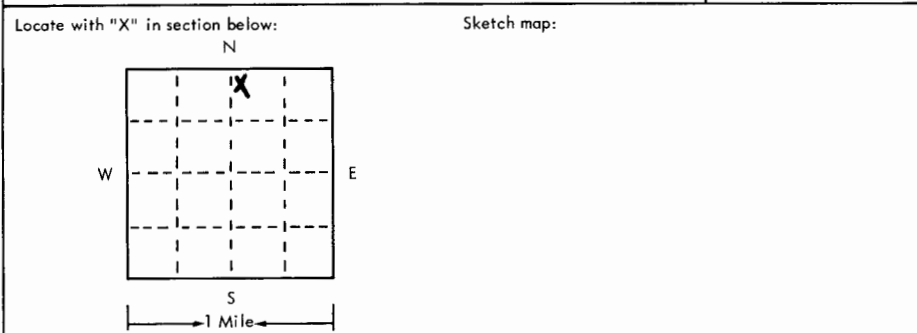

4 Well depth: **320** ft. Date of completion **6-10-75**
Well diameter **26** in.

5 Cable tool Rotary Driven Dug
 Hollow rod Jetted Bored Reverse rotary

6 Use: Domestic Public supply Industry
 Irrigation Air conditioning Commercial
 Test well

7 Casing: Material **steel** Height: above/below
Threaded Welded Surface **12** in.
Diam. Weight _____ lbs./ft. _____
16 in. to **320** ft. depth Drive shoe? Yes No
_____ in. to _____ ft. depth!

2	Type and color of material	From	To
	Topsoil	0	3
	Sandy Clay	3	110
	Coarse Sand	110	120
	Clay	120	133
	Coarse Sand	133	159
	Sand	159	165
	Sand and Gravel	165	180
	Sand (fine) & Clay	180	185
	Clay	185	190
	Coarse Sand	190	210
	Sand & Gravel	210	291
	Coarse Sand	291	295
	Sand & Gravel	295	320
	(use a second sheet if needed)		

8 Screen:
Manufacturer **W. A. Brown**
Type **Free Flo** Dia. **16"**
Slot/gauze **Slot** Length **2"**
Set between **240** ft. and **320** ft. _____
Fittings:
Gravel pack Yes No Size range of material **5/8**

9 Static water level:
184 ft. below land surface Date **6-1-65**

10 Pumping level below land surfaces: **Not Test**
_____ ft. after _____ hrs. pumping **Dumped** p.m.
_____ ft. after _____ hrs. pumping _____ g.p.m.
Estimated maximum yield **1400** g.p.m.

11 Water sample submitted:
 Yes No Date _____

12 Well head completion:
 Pitless adapter Inches above grade

13 Well grouted? Yes No
 Neat cement Bentonite _____
Depth: From **0** ft. to **10** ft.

14 Nearest source of possible contamination: **None**
ft. _____ Direction _____ Type _____
Well disinfected upon completion? Yes No

15 Pump: Not installed
Manufacturer's name **Layne**
Model number **1975** HP **100** Volts _____
Length of drop pipe **240** ft. capacity **1200** g.p.m.
Type:
 Submersible Turbine
 Jet Reciprocating
 Centrifugal Other

16 Remarks: elevation

Topography: **Machined Levelled**

Hill
 Slope
 Upland
 Valley

17 Water well contractor's certification:
This well was drilled under my jurisdiction and this report is true to the best of my knowledge and belief.

Dunham Drilling **223**
Business name License No.
Address **Copeland, Kansas**
Signed **[Signature]** Date **6-20-75**
Authorized representative