


1 LOCATION OF WATER WELL: Fraction NE 1/4 NE 1/4 NE 1/4 Section Number 26 Township Number T 30 S Range Number R 31 E/W
 County: HASKELL

Distance and direction from nearest town or city street address of well if located within city?
 4 Miles South and 9 Miles East of Sublette, KS

2 WATER WELL OWNER: Twila Stapleton
 RR#, St. Address, Box #: Rt. 1, Box 85 Board of Agriculture, Division of Water Resources
 City, State, ZIP Code: Plains, KS 67869 Application Number: ---

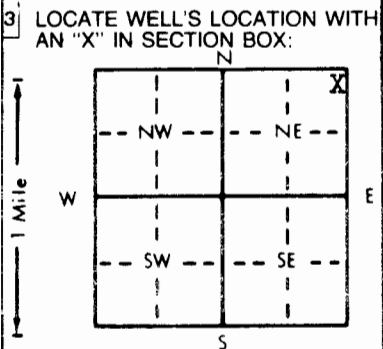

4 DEPTH OF COMPLETED WELL: 320 ft. ELEVATION: Slope
 Depth(s) Groundwater Encountered: 1 Not available ft. 2 ft. 3 ft.
 WELL'S STATIC WATER LEVEL: 212 ft. below land surface measured on mo/day/yr August 1, 1990.
 Pump test data: Well water was ft. after hours pumping gpm
 Est. Yield: 30 gpm: Well water was ft. after hours pumping gpm
 Bore Hole Diameter: 10 in. to 320 ft., and in. to ft.
 WELL WATER TO BE USED AS:
 Domestic 3 Feedlot 6 Oil field water supply 9 Dewatering 12 Other (Specify below)
 2 Irrigation 4 Industrial 7 Lawn and garden only 10 Monitoring well
 Was a chemical/bacteriological sample submitted to Department? Yes No : If yes, mo/day/yr sample was submitted
 Water Well Disinfected? Yes No

5 TYPE OF BLANK CASING USED:
 1 Steel 3 RMP (SR) 5 Wrought iron 8 Concrete tile CASING JOINTS: Glued Clamped
 PVC 4 ABS 7 Fiberglass Welded
 Blank casing diameter: 5 in. to 280 ft. Dia. in. to ft. Dia. in. to ft.
 Casing height above land surface: 18 in. weight: 2.8 lbs./ft. Wall thickness or gauge No. 265
 TYPE OF SCREEN OR PERFORATION MATERIAL: PVC 10 Asbestos-cement
 1 Steel 3 Stainless steel 5 Fiberglass 8 RMP (SR) 11 Other (specify)
 2 Brass 4 Galvanized steel 6 Concrete tile 9 ABS 12 None used (open hole)
 SCREEN OR PERFORATION OPENINGS ARE:
 1 Continuous slot 3 Mill slot 5 Gauzed wrapped Saw cut 11 None (open hole)
 2 Louvered shutter 4 Key punched 6 Wire wrapped 9 Drilled holes
 7 Torch cut 10 Other (specify)
 SCREEN-PERFORATED INTERVALS: From 280 ft. to 320 ft. From ft. to ft.
 GRAVEL PACK INTERVALS: From 30 ft. to 320 ft. From ft. to ft.

6 GROUT MATERIAL: 1 Neat cement 2 Cement grout 3 Bentonite Other Baroid Hole Plug
 Grout Intervals: From 0 ft. to 30 ft. From ft. to ft. From ft. to ft.
 What is the nearest source of possible contamination:
 Septic tank 4 Lateral lines 7 Pit privy 10 Livestock pens 14 Abandoned water well
 2 Sewer lines 5 Cess pool 8 Sewage lagoon 11 Fuel storage 15 Oil well/Gas well
 3 Watertight sewer lines 6 Seepage pit 9 Feedyard 12 Fertilizer storage 16 Other (specify below)
 13 Insecticide storage
 Direction from well? South How many feet? 100

FROM	TO	LITHOLOGIC LOG	FROM	TO	PLUGGING INTERVALS
0	2	Topsoil			
2	91	Clay			
91	147	Large Sand			
147	192	Blue Clay			
192	280	Med. to Lar. Sand & Gravel			
280	300	Blue Clay			
300	320	Med. to Lar. Sand & Gravel			
320	400	Blue Clay			

7 CONTRACTOR'S OR LANDOWNER'S CERTIFICATION: This water well was (1) constructed, (2) reconstructed, or (3) plugged under my jurisdiction and was completed on (mo/day/year) August 2, 1990 and this record is true to the best of my knowledge and belief. Kansas Water Well Contractor's License No. 252 This Water Well Record was completed on (mo/day/yr) August 13, 1990 under the business name of Friesen Windmill & Supply Inc. by (signature)

INSTRUCTIONS: Use typewriter or ball point pen. PLEASE PRESS FIRMLY and PRINT clearly. Please fill in blanks, underline or circle the correct answers. Send top three copies to Kansas Department of Health and Environment, Bureau of Water, Topeka, Kansas 66620-7320. Telephone: 913-296-5545. Send one to WATER WELL OWNER and retain one for your records.

1600071006-22

OFFICE USE ONLY
T
R
EW
SEC
1/4
1/4
1/4