


1 LOCATION OF WATER WELL: Fraction $\frac{1}{4}$ $\frac{1}{2}$ $\frac{3}{4}$ Section Number 16 Township Number 30 Range Number 31 E/W

Distance and direction from nearest town or city street address of well if located within city?
SE Corner Sublette - 7 miles East to Rd W - 1045' North 440' West 3 miles South

2 WATER WELL OWNER:
Fry Family Farms LLC
 RR#, St. Address, Box #:
PO Box 1013 Old Ed Building
 City, State ZIP Code:
Garden City KS 67846

Global Positioning Systems (decimal degrees, min. of 4 digits)
 Latitude: _____
 Longitude: _____
 Elevation: _____
 Datum: _____
 Data Collection Method: _____

3 MARK WELL'S LOCATION WITH AN "X" IN SECTION BOX:

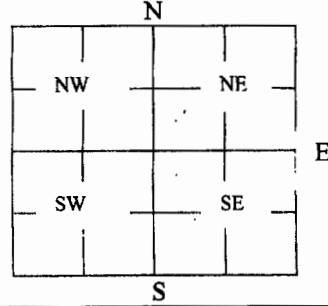

4 DEPTH OF WELL 450 ft.
 WELL'S STATIC WATER LEVEL 300 ft.

WELL WAS USED AS:

1 Domestic	5 Public Water Supply	9 Dewatering
<u>2 Irrigation</u>	6 Oil Field Water Supply	10 Monitoring
3 Feedlot	7 Domestic (Lawn & Garden)	11 Injection Well
4 Industrial	8 Air Conditioning	12 Other _____

Was a chemical/bacteriological sample submitted to Department? Yes _____ No _____

5 TYPE OF BLANK CASING USED:

<u>1 Steel</u>	3 RMP (SR)	5 Wrought	7 Fiberglass	9 Other (Specify below)
2 PVC	4 ABS	6 Asbestos-Cement	8 Concrete Tile	_____

Blank casing diameter 16 in. Was casing pulled? Yes _____ No X If yes, how much _____
 Casing height above or below land surface 3' in.

6 GROUT PLUG MATERIAL: 1 Neat cement 2 Cement grout 3 Bentonite 4 Other _____

Grout Plug Intervals: From 450 ft. to 300 ft., From 300 ft. to 285 ft., From 285 to 15 ft.

What is the nearest source of possible contamination:

1 Septic tank	6 Seepage pit	11 Fuel Storage	16 Other (specify below)
2 Sewer lines	7 Pit privy	12 Fertilizer storage	<u>NONE</u>
3 Watertight sewer lines	8 Sewage lagoon	13 Insecticide storage	
4 Lateral lines	9 Feedyard	14 Abandoned water well	Direction from well? _____
5 Cess pool	10 Livestock pens	15 Oil well/Gas well	How many feet? _____

FROM	TO	PLUGGING MATERIALS	FROM	TO	PLUGGING MATERIALS
<u>450</u>	<u>300</u>	<u>Chlorinated gravel</u>			
<u>300</u>	<u>285</u>	<u>Hook plug</u>			
<u>285</u>	<u>15</u>	<u>Inert material</u>			
<u>15</u>	<u>3</u>	<u>Cement</u>			
<u>3</u>	<u>0</u>	<u>DIRT & leveled area</u>			

7 CONTRACTOR'S OR LANDOWNER'S CERTIFICATION: This water well was plugged under my jurisdiction and was completed on (mo/day/year) 10-10-16 and this record is true to the best of my knowledge and belief. Kansas Water Well Contractor's License No. 927 This Water Well Record was completed on (mo/day/year) 1-9-17 under the business name of Kirk Water Wells LLC by (signature) (Henry)

INSTRUCTIONS: Use typewriter or ballpoint pen. Please press firmly and print clearly. Please fill in blanks, underline or circle the correct answers. Send top three copies to Kansas Department of Health and Environment, Bureau of Water, Geology Section, 1000 SW Jackson St., Ste. 420, Topeka, Kansas 66612-1367. Telephone: 785/296-5522. Send one to Water Well Owner and retain one for your records. Visit us at <http://www.kdheks.gov/geo/waterwells>.