WATER WELL RECORD Form WWC-5 KSA 82a-1212

| 1 LOCATION OF WATER WELL: | Fraction | Section Number | Township Number | Range Number |
|---|---|---|---|---|
| County: Haskell | SW ¼ SW ¼ NW ¼ | 4 | T 30 S | R 32 E(W) |

Distance and direction from nearest town or city street address of well if located within city?
1 mile east &2miles south of Sublette, Ks.

2 WATER WELL OWNER: Ed Wiswell
RR#, St. Address, Box # : 706 S. Pursley
City, State, ZIP Code : Sublette, Ks. 67877
Board of Agriculture, Division of Water Resources
Application Number:

3 LOCATE WELL'S LOCATION WITH AN "X" IN SECTION BOX:

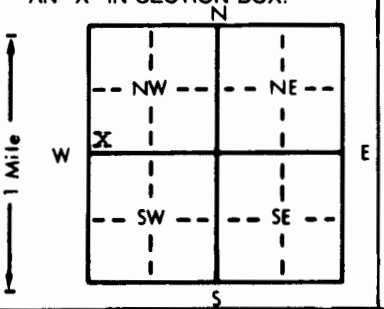


4 DEPTH OF COMPLETED WELL 410 ft. ELEVATION:
Depth(s) Groundwater Encountered 1. ft. 2. ft. 3. ft.
WELL'S STATIC WATER LEVEL 275 ft. below land surface measured on mo/day/yr 6-19-86
Pump test data: Well water was ft. after hours pumping gpm
Est. Yield 35 gpm: Well water was ft. after hours pumping gpm
Bore Hole Diameter 12 in. to 410 ft., and in. to ft.
WELL WATER TO BE USED AS: 5 Public water supply 8 Air conditioning 11 Injection well
X Domestic 3 Feedlot 6 Oil field water supply 9 Dewatering 12 Other (Specify below)
2 Irrigation 4 Industrial 7 Lawn and garden only 10 Observation well
Was a chemical/bacteriological sample submitted to Department? Yes ..... No X ; If yes, mo/day/yr sample was submitted
Water Well Disinfected? Yes X No

5 TYPE OF BLANK CASING USED: 5 Wrought iron 8 Concrete tile CASING JOINTS: Glued X Clamped
1 Steel 3 RMP (SR) 6 Asbestos-Cement 9 Other (specify below) Welded
X PVC 4 ABS 7 Fiberglass Threaded
Blank casing diameter 5 in. to 390 ft., Dia in. to ft., Dia in. to ft.
Casing height above land surface 12 in., weight lbs./ft. Wall thickness or gauge No. 200 psi

TYPE OF SCREEN OR PERFORATION MATERIAL: X PVC 10 Asbestos-cement
1 Steel 3 Stainless steel 5 Fiberglass 8 RMP (SR) 11 Other (specify)
2 Brass 4 Galvanized steel 6 Concrete tile 9 ABS 12 None used (open hole)

SCREEN OR PERFORATION OPENINGS ARE: 5 Gauzed wrapped X 8 Saw cut 11 None (open hole)
1 Continuous slot 3 Mill slot 6 Wire wrapped 9 Drilled holes
2 Louvered shutter 4 Key punched 7 Torch cut 10 Other (specify)

SCREEN-PERFORATED INTERVALS: From 360 ft. to 410 ft., From ft. to ft.
From 330 ft. to 350 ft., From ft. to ft.
GRAVEL PACK INTERVALS: From 17 ft. to 380 ft., From ft. to ft.
From 390 ft. to 410 ft., From ft. to ft.

6 GROUT MATERIAL: X Neat cement 2 Cement grout X Bentonite 4 Other
Grout Intervals: From 2 ft. to 17 ft., From 280 ft. to 390 ft., From ft. to ft.

What is the nearest source of possible contamination:
X Septic tank 4 Lateral lines 7 Pit privy 10 Livestock pens 14 Abandoned water well
2 Sewer lines 5 Cess pool 8 Sewage lagoon 11 Fuel storage 15 Oil well/Gas well
3 Watertight sewer lines 6 Seepage pit 9 Feedyard 12 Fertilizer storage 16 Other (specify below)
13 Insecticide storage
Direction from well? How many feet? 100

| FROM | TO | LITHOLOGIC LOG | FROM | TO | LITHOLOGIC LOG |
|---|---|---|---|---|---|
| 0 | 2 | top soil | | | |
| 2 | 80 | brown clay | | | |
| 80 | 140 | fine & coarse sand & gravel, clay streaks | | | |
| 140 | 180 | brown clay | | | |
| 180 | 200 | fine sand, clay streaks | | | |
| 200 | 210 | brown clay | | | |
| 210 | 220 | fine & coarse sand | | | |
| 220 | 240 | brown clay | | | |
| 240 | 280 | blue clay | | | |
| 280 | 309 | brown clay | | | |
| 309 | 320 | fine sand | | | |
| 320 | 330 | brown clay | | | |
| 330 | 350 | fine & coarse sand, small gravel | | | |
| 350 | 360 | brown clay | | | |
| 360 | 410 | fine & coarse sand, few clay streaks | | | |

7 CONTRACTOR'S OR LANDOWNER'S CERTIFICATION: This water well was (1) X constructed, (2) reconstructed, or (3) plugged under my jurisdiction and was completed on (mo/day/year) 6-19-86 and this record is true to the best of my knowledge and belief. Kansas Water Well Contractor's License No. 449 This Water Well Record was completed on (mo/day/yr) 6-24-86
under the business name of Midwest Well & Pump by (signature) Arthur Buhlmeier

INSTRUCTIONS: Use typewriter or ball point pen. *PLEASE PRESS FIRMLY* and *PRINT* clearly. Please fill in blanks, underline or circle the correct answers. Send top three copies to Kansas Department of Health and Environment, Office of Oil Field and Environmental Geology, Regulation and Permitting Section, Topeka, Kansas 66620-7500, Telephone: 913-862-9360. Send one to WATER WELL OWNER and retain one for your records.

OFFICE USE ONLY T R EW SEC. ¼ ¼ ¼