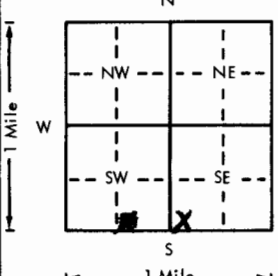
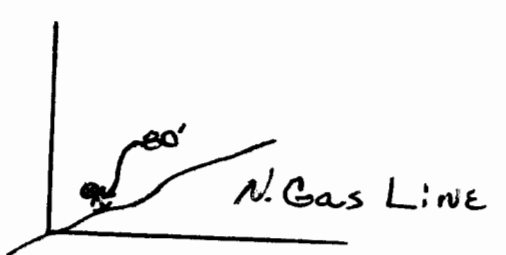


USE TYPEWRITER OR BALL  
POINT PEN-PRESS FIRMLY,  
PRINT CLEARLY.

WATER WELL RECORD  
KSA 82a-1201-1215

Kansas Department of Health and  
Environment-Division of Environment  
(Water well Contractors)  
Topeka, Kansas 66620

1. Location of well:		County <u>Haskell</u>	Fraction <u>SW 1/4 SW 1/4 SE 1/4</u>	Section number <u>28</u>	Township number <u>T 30 S R 32 E 0</u>	Range number <u>32</u>
2. Distance and direction from nearest town or city: Street address of well location if in city:			3. Owner of well: R.R. or street: City, state, zip code:			
<u>5 S. &amp; 1/2 E</u> <u>of Sublette, Ks.</u>			<u>Norman Sherman</u> <u>600 Wichita</u> <u>McAllen, Tex. 78501</u>			
4. Locate with "X" in section below:		Sketch map:		6. Bore hole dia. <u>28</u> in. Completion date <u>6-18-76</u> Well depth <u>460</u> ft.		
				7. <input checked="" type="checkbox"/> Cable tool <input checked="" type="checkbox"/> Rotary <input type="checkbox"/> Driven <input type="checkbox"/> Dug <input type="checkbox"/> Hollow rod <input type="checkbox"/> Jetted <input type="checkbox"/> Bored <input type="checkbox"/> Reverse rotary		
5. Type and color of material		From	To	8. Use: <input type="checkbox"/> Domestic <input type="checkbox"/> Public supply <input type="checkbox"/> Industry <input checked="" type="checkbox"/> Irrigation <input type="checkbox"/> Air conditioning <input type="checkbox"/> Stock <input type="checkbox"/> Lawn <input type="checkbox"/> Oil field water <input type="checkbox"/> Other		
Top soil and clay		0	90	9. Casing: Material <u>STL</u> Height: Above <u>as below</u> Threaded <input type="checkbox"/> Welded <input checked="" type="checkbox"/> Surface <u>12</u> in. RMP <input type="checkbox"/> PVC <input type="checkbox"/> Weight <u>      </u> lbs./ft. Dia <u>16</u> in. to <u>460</u> ft. depth Wall Thickness: inches or Dia. <u>      </u> in. to <u>      </u> ft. depth gage No. <u>219</u>		
Coarse sand, gravel, and clay streaks		90	150	10. Screen: Manufacturer's name <u>FASTER</u> Type <u>MILL slot</u> Dia. <u>16"</u> Slot/gage <u>100</u> Length <u>24-283</u> Set between <u>177</u> ft. and <u>460</u> ft. <u>      </u> ft. and <u>      </u> ft. Gravel pack? <u>YES</u> Size range of material <u>1/2" DOWD</u>		
Coarse sand and fine gravel		150	180	11. Static water level: <u>      </u> mo./day/yr. <u>      </u> ft. below land surface Date <u>      </u>		
" "		180	210	12. Pumping level below land surfaces: <u>282</u> ft. after <u>6</u> hrs. pumping <u>1400</u> g.p.m. <u>      </u> ft. after <u>      </u> hrs. pumping <u>      </u> g.p.m. Estimated maximum yield <u>1400</u> g.p.m.		
Coarse sand, large gravel (1/2") and clay streaks		210	240	13. Water sample submitted: <u>      </u> mo./day/yr. <input type="checkbox"/> Yes <input checked="" type="checkbox"/> No Date <u>      </u>		
Coarse sand		240	270	14. Well head completion: <input type="checkbox"/> Pitless adapter <u>12</u> inches above grade		
Coarse sand, gravel, and brown and blue clay streaks		270	300	15. Well grouted? <u>YES</u> With: <input type="checkbox"/> Neat cement <input type="checkbox"/> Bentonite <input checked="" type="checkbox"/> Concrete Depth: From <u>0</u> ft. to <u>10</u> ft.		
Coarse sand and gravel		300	330	16. Nearest source of possible contamination: ft. <u>10</u> above <u>      </u> Type <u>      </u> Well disinfected upon completion? <input type="checkbox"/> Yes <input checked="" type="checkbox"/> No		
" "		330	360	17. Pump: <u>      </u> Not installed Manufacturer's name <u>Whetstone Tool (Customers)</u> Model number <u>15M154</u> HP <u>160</u> Volts <u>      </u> Length of drop pipe <u>380</u> ft. capacity <u>2000</u> g.p.m. Type: <input type="checkbox"/> Submersible <input checked="" type="checkbox"/> Turbine <input type="checkbox"/> Jet <input type="checkbox"/> Reciprocating <input type="checkbox"/> Centrifugal <input type="checkbox"/> Other		
Coarse sand and gravel 390-410 Sand stone		380	420	20. Water well contractor's certification: This well was drilled under my jurisdiction and this report is true to the best of my knowledge and belief. <u>CLEMENS IRR. DRG. 330</u> Business name <u>Bo. Box 499 Liberal, Ks.</u> License No. <u>      </u> Address <u>      </u> Signed <u>      </u> Date <u>6-25-76</u> Authorized representative		
Clay and med. sand streaks		420	450			
Fine sand and clay		450	480			
(Use a second sheet if needed)						
18. Elevation:		19. Remarks:				
Topography: <input type="checkbox"/> Hill <input type="checkbox"/> Slope <input checked="" type="checkbox"/> Upland <input type="checkbox"/> Valley						

Forward the white, blue and pink copies to the Department of Health and Environment

Form WWC-5