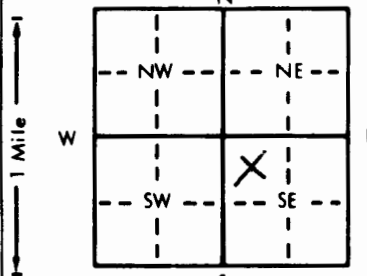


1 LOCATION OF WATER WELL:	Fraction	Section Number	Township Number	Range Number
County: <u>Haskell</u>	<u>C</u> $\frac{1}{4}$ NW $\frac{1}{4}$ SE $\frac{1}{4}$	<u>20</u>	<u>T</u> <u>30</u> <u>S</u>	<u>R</u> <u>33</u> <u>EW</u>

Distance and direction from nearest town or city street address of well if located within city?

1 3/4 mile south, 1 1/2 mile east of Satanta

2 WATER WELL OWNER: <u>Viola Grubbs</u>	<u>Murfin Drilling, Inc.</u>
RR#, St. Address, Box #: <u>Abeline, Tx. 69606 Box 661</u>	Board of Agriculture, Division of Water Resources
City, State, ZIP Code: <u>Colby, Ks. 67701</u>	Application Number: <u>930444</u>

3 LOCATE WELL'S LOCATION WITH AN "X" IN SECTION BOX:	4 DEPTH OF COMPLETED WELL: <u>320</u> ft. ELEVATION:
	Depth(s) Groundwater Encountered 1. ft. 2. ft. 3. ft.
	WELL'S STATIC WATER LEVEL <u>297</u> ft. below land surface measured on mo/day/yr
	Pump test data: Well water was ft. after hours pumping gpm
	Est. Yield gpm: Well water was ft. after hours pumping gpm
	Bore Hole Diameter <u>8</u> in. to <u>320</u> ft., and in. to ft.
	WELL WATER TO BE USED AS:
	5 Public water supply 8 Air conditioning 11 Injection well
	1 Domestic 3 Feedlot 6 Oil field water supply 9 Dewatering 12 Other (Specify below)
	2 Irrigation 4 Industrial 7 Lawn and garden only 10 Monitoring well
	Was a chemical/bacteriological sample submitted to Department? Yes.....No <u>X</u>; If yes, mo/day/yr sample was submitted
	Water Well Disinfected? Yes No <u>X</u>

5 TYPE OF BLANK CASING USED:	5 Wrought iron	8 Concrete tile	CASING JOINTS: Glued <u>X</u> Clamped
1 Steel	3 RMP (SR)	6 Asbestos-Cement	9 Other (specify below)
2 PVC	4 ABS	7 Fiberglass	Welded
Blank casing diameter <u>4.5</u> in. to <u>280</u> ft., Dia			Threaded
Casing height above land surface <u>18</u> in., weight	<u>2.38</u> lbs./ft.	Wall thickness or gauge No. <u>248</u>	
TYPE OF SCREEN OR PERFORATION MATERIAL:	7 PVC	10 Asbestos-cement	
1 Steel	3 Stainless steel	5 Fiberglass	8 RMP (SR)
2 Brass	4 Galvanized steel	6 Concrete tile	9 ABS
SCREEN OR PERFORATION OPENINGS ARE:	5 Gauzed wrapped	8 Saw cut	11 None (open hole)
1 Continuous slot	3 Mill slot	6 Wire wrapped	9 Drilled holes
2 Louvered shutter	4 Key punched	7 Torch cut	10 Other (specify)
SCREEN-PERFORATED INTERVALS:	From <u>280</u> ft. to <u>320</u> ft.	From	ft. to
	From	ft. to	ft. to
GRAVEL PACK INTERVALS:	From <u>20</u> ft. to <u>320</u> ft.	From	ft. to
	From	ft. to	ft. to

6 GROUT MATERIAL:	1 Neat cement	2 Cement grout	3 Bentonite	4 Other
Grout Intervals: From <u>0</u> ft. to <u>20</u> ft., From				
What is the nearest source of possible contamination:	10 Livestock pens	14 Abandoned water well		
1 Septic tank	4 Lateral lines	7 Pit privy	11 Fuel storage	15 Oil well/Gas well
2 Sewer lines	5 Cess pool	8 Sewage lagoon	12 Fertilizer storage	16 Other (specify below)
3 Watertight sewer lines	6 Seepage pit	9 Feedyard	13 Insecticide storage	
Direction from well? <u>East</u>			How many feet? <u>150'</u>	

FROM	TO	LITHOLOGIC LOG	FROM	TO	PLUGGING INTERVALS
0	2	Surface			
2	34	Loess/Caliche Lenses			
34	37	Caliche			
37	82	Clay Caliche/Fine Sand Lenses			
82	92	Sand & Gravel			
92	96	Clay & Sand Strks.			
96	99	Gravel			
99	113	Caliche Clay & Cemented Strks.			
113	254	Loose Sand & Gravel			
254	282	Sandy Clay & Caliche Strks.			
282	299	Fine to Med. Sand w/Clay Strks.			
299	301	Clay			
301	320	Med. Sand/Clay & Caliche Strks.			

7 CONTRACTOR'S OR LANDOWNER'S CERTIFICATION: This water well was (1) constructed, (2) reconstructed, or (3) plugged under my jurisdiction and was completed on (mo/day/year) <u>11-20-93</u> and this record is true to the best of my knowledge and belief. Kansas Water Well Contractor's License No. <u>554</u> This Water Well Record was completed on (mo/day/yr) <u>11-22-93</u> under the business name of <u>Woofter Pump & Well, Inc.</u> by (signature) <u>[Signature]</u>
--