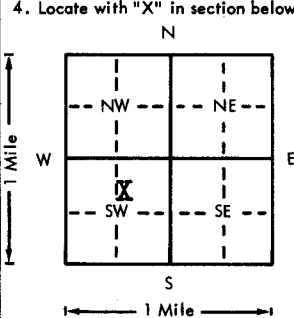


USE TYPEWRITER OR BALL
POINT PEN—PRESS FIRMLY,
PRINT CLEARLY.

WATER WELL RECORD
KSA 82a-1201-1215

Kansas Department of Health and
Environment—Division of Environment
(Water well Contractors)
Topeka, Kansas 66620

1. Location of well:	County HASKELL	Fraction SW 1/4 NE 1/4 SW 1/4	Section number 22	Township number T 30 S R 33	Range number 33
2. Distance and direction from nearest town or city: South of Garden City on Hwy 83 to 56 Jct., 3 South, 3 West, Street address of well location if in city: 1/2 South, 1/4 East.			3. Owner of well: Henry Harlow R.R. or street: City, state, zip code: Satanta, Kansas 67870		
4. Locate with "X" in section below: 			Sketch map:		
5. Type and color of material			From	To	6. Bore hole dia. 26 in. Completion date 10-16-75 Well depth 155 ft.
					7. <input type="checkbox"/> Cable tool <input type="checkbox"/> Rotary <input type="checkbox"/> Driven <input type="checkbox"/> Dug <input type="checkbox"/> Hollow rod <input type="checkbox"/> Jetted <input type="checkbox"/> Bored <input checked="" type="checkbox"/> Reverse rotary
					8. Use: <input type="checkbox"/> Domestic <input type="checkbox"/> Public supply <input type="checkbox"/> Industry <input checked="" type="checkbox"/> Irrigation <input type="checkbox"/> Air conditioning <input type="checkbox"/> Stock <input type="checkbox"/> Lawn <input type="checkbox"/> Oil field water <input type="checkbox"/> Other
					9. Casing: Material Steel Height: Above or below Threaded <input type="checkbox"/> Welded <input checked="" type="checkbox"/> Surface 12 in. RMP <input type="checkbox"/> PVC <input type="checkbox"/> Weight 36.87 lbs./ft. Dia. 16 in. to 156 ft. depth Wall Thickness: inches or Dia. <input type="checkbox"/> in. to <input type="checkbox"/> ft. depth gage No. 2.29 MAC
					10. Screen: Manufacturer's name Johnson Division Type Galvanized Dia. 16" Slot/gauze <input type="checkbox"/> Length 20' Set between 100 ft. and 120 ft. Perf: 240-100 ft. and 120-155 ft. Gravel pack? Yes Size range of material 3" down
					11. Static water level: 245 ft. below land surface Date 9-26-75
					12. Pumping level below land surfaces: 254 ft. after 2 hrs. pumping 672 g.p.m. 261 ft. after 4 hrs. pumping 1150 g.p.m. Estimated maximum yield <input type="checkbox"/> g.p.m.
					13. Water sample submitted: <input type="checkbox"/> Yes <input checked="" type="checkbox"/> No Date <input type="checkbox"/>
					14. Well head completion: <input type="checkbox"/> Pitless adapter 12 inches above grade
					15. Well grouted? Yes With: <input checked="" type="checkbox"/> Neat cement <input type="checkbox"/> Bentonite <input type="checkbox"/> Concrete Depth: From 0 ft. to 10 ft.
					16. Nearest source of possible contamination: N/A ft. <input type="checkbox"/> Direction <input type="checkbox"/> Type <input type="checkbox"/> Well disinfected upon completion? <input type="checkbox"/> Yes <input checked="" type="checkbox"/> No
					17. Pump: <input type="checkbox"/> Not installed Manufacturer's name Customer's old pump Model number <input type="checkbox"/> HP <input type="checkbox"/> Volts <input type="checkbox"/> Length of drop pipe 320 ft. capacity <input type="checkbox"/> g.p.m. Type: <input type="checkbox"/> Submersible <input type="checkbox"/> Turbine <input type="checkbox"/> Jet <input type="checkbox"/> Reciprocating <input type="checkbox"/> Centrifugal <input type="checkbox"/> Other
(Use a second sheet if needed)					
18. Elevation:	19. Remarks: CUSTOMER'S OLD PUMP		20. Water well contractor's certification: This well was drilled under my jurisdiction and this report is true to the best of my knowledge and belief. Minter-Wilson Drilling 208 Business name Box A, Garden City, KS License No. 415176 Address Box A, Garden City, KS Signed Minter-Wilson Drilling Date 4/15/76 Authorized representative		

Forward the white, blue and pink copies to the Department of Health and Environment

Form WWC-5

The
Professional

MINTER-WILSON DRILLING CO.

INCORPORATED

Irrigation
and Domestic
Water Systems
Complete Installation
and Repairing

Phone 276-8269 • P.O. Box 493 • GARDEN CITY, KANSAS 67846

HENRY HARLOW
Haskell County
8-29-75

Location: SW 22-30-33 60 ft. East of No. 1; East on
North side of $\frac{1}{4}$

Static Water Level - 215

Test # 2

0	1	Top soil
1	53	Brown clay
53	82	Brown sandy clay & fine sand
82	115	Fine to med. sand & gravel (Loose)
115	142	Brown sandy clay 30% Fine to med. sand
142	155	Fine to med. sand & gravel 10% clay (Loose)
155	170	Brown clay
170	276	Fine to med. sand & gravel (Loose)
276	281	Brown sandy clay
281	308	Fine to med. sand & gravel (Loose)
308	360	Fine to med. sand & gravel 10% clay (Loose)
360	428	Fine to med. sand & gravel (Loose)
428	455	Fine to med. sand & gravel 10% clay (Loose)
455	488	Brown & gray clay with white rock (Hard)
488	500	Brown gray & yellow clay (Hard)

TD- 455'

20' Screen

Used Casing