

County: Rawlins Fraction: SE, SE, NE, NE Sec. 3 T. 3 S R. 33 W

**CORRECTION(S) to WATER WELL COMPLETION RECORD Form WWC-5 (to rectify lacking or incorrect information)**

Owner: Jim & Vicki Kogl North well 55 ft TD

If location corrected, was listed as:

Location changed to:

Section-Township-Range: \_\_\_\_\_

\_\_\_\_\_

Fraction (1/4 calls): NE, SE, NE, SW

SE, SE, NE, NE

Other changes: Initial statements: Lat. 39.82468, Long. -101.00051; No Horizontal Datum provided.

Blank casing: unknown; Bentonite grout 8 ft to '-'. Directions to well not provided.

Changed to: Lat. 39.824811 N, Long. -101.000710 W, Google Earth H. Datum WGS84. Top of casing below ground in well pit. Blank casing: steel. Four (4) miles E of Atwood on 36 Hwy & 1.5 mile N.

Comments: Talked to person who plugged well (Mike Pochop) & NWLEPG staff about well details and location.

Verification method: Confirmed on Google Earth and KDHE STR Finder.

QF for well is SW, SE, SE, NE, NE.

Initials: PKC Date: 8/5/2020

Submitted by:  Kansas Geological Survey, Data Resources Library, 1930 Constant Ave., Lawrence, KS 66047-3724  
 Kansas Dept. of Health & Environment, Bureau of Water, 1000 SW Jackson, Suite 420, Topeka, KS 66612-1367


<b>1 LOCATION OF WATER WELL:</b> County: <u>Quinn</u>	Fraction <u>NE 1/4 SE 1/4 NE 1/4 SW 1/4</u>	Section Number <u>3</u>	Township Number <u>3T S</u>	Range Number <u>33</u> <input type="checkbox"/> E <input type="checkbox"/> W
--	--	----------------------------	--------------------------------	---

Street/Rural Address of Well Location: if unknown, distance & direction from nearest town or intersection: If at owner's address, check here

**Global Positioning Systems (GPS) information:**  
 Latitude: 39.82468 (in decimal degrees)  
 Longitude: -101.60051 (in decimal degrees)  
 Elevation: \_\_\_\_\_  
 Horizontal Datum:  WGS84,  NAD83,  NAD27  
 Collection Method: \_\_\_\_\_

**2 WATER WELL OWNER:** Jim Vicks Kuhl  
 RR#, St. Address, Box #: 13332 R02350  
 City, State ZIP Code: Atwood ks 67730

GPS unit (Make/Model: \_\_\_\_\_)  
 Digital Map/Photo,  Topographic Map,  Land Survey  
 Est. Accuracy:  < 3 m,  3-5 m,  5-15 m,  > 15 m

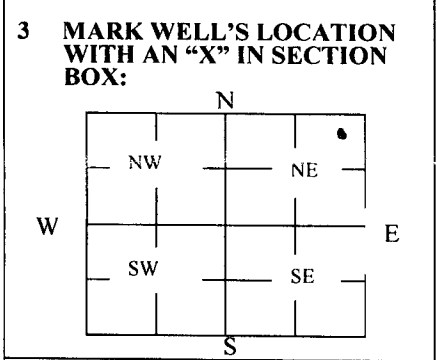

**4 DEPTH OF WELL** 55 ft.  
 WELL'S STATIC WATER LEVEL 30 ft  
 WELL WAS USED AS:

<input checked="" type="checkbox"/> Domestic	<input type="checkbox"/> Public Water Supply	<input type="checkbox"/> Dewatering
<input type="checkbox"/> Irrigation	<input type="checkbox"/> Oil Field Water Supply	<input type="checkbox"/> Monitoring
<input type="checkbox"/> Feedlot	<input type="checkbox"/> Domestic (Lawn & Garden)	<input type="checkbox"/> Injection Well
<input type="checkbox"/> Industrial	<input type="checkbox"/> Air Conditioning	<input type="checkbox"/> Other _____

Was a chemical/bacteriological sample submitted to Department? Yes  No

**5 TYPE OF BLANK CASING USED:**

<input type="checkbox"/> Steel	<input type="checkbox"/> RMP (SR)	<input type="checkbox"/> Wrought	<input type="checkbox"/> Fiberglass	<input type="checkbox"/> Other (Specify below)
<input type="checkbox"/> PVC	<input type="checkbox"/> ABS	<input type="checkbox"/> Asbestos-Cement	<input type="checkbox"/> Concrete Tile	<u>unbranded</u>

Blank casing diameter 6 in. Was casing pulled? Yes  No  If yes, how much \_\_\_\_\_  
 Casing height above or below land surface 6 in.

**6 GROUT PLUG MATERIAL:**  Neat cement  Cement grout  Bentonite  Other fill sand

Grout Plug Intervals: From 50 ft. to 8 ft., From 8 ft. to - ft., From \_\_\_\_\_ ft. to \_\_\_\_\_ ft.

What is the nearest source of possible contamination:

<input type="checkbox"/> Septic tank	<input type="checkbox"/> Seepage pit	<input type="checkbox"/> Fuel storage	<input type="checkbox"/> Other (specify below)
<input type="checkbox"/> Sewer lines	<input type="checkbox"/> Pit privy	<input type="checkbox"/> Fertilizer storage	_____
<input type="checkbox"/> Watertight sewer lines	<input type="checkbox"/> Sewage lagoon	<input type="checkbox"/> Insecticide storage	_____
<input type="checkbox"/> Lateral lines	<input type="checkbox"/> Feedyard	<input type="checkbox"/> Abandoned water well	Direction from well? _____
<input type="checkbox"/> Cess pool	<input type="checkbox"/> Livestock pens	<input type="checkbox"/> Oil well/Gas well	How many feet? _____

FROM	TO	PLUGGING MATERIALS	FROM	TO	PLUGGING MATERIALS
<u>50</u>	<u>8</u>	<u>fill sand</u>	<u>8</u>	<u>-</u>	<u>Bentonite</u>

**7 CONTRACTOR'S OR LANDOWNER'S CERTIFICATION:** This water well was plugged under my jurisdiction and was completed on (mo/day/year) 6-23-20 and this record is true to the best of my knowledge and belief. Kansas Water Well Contractor's License No. \_\_\_\_\_, This Water Well Record was completed on (mo/day/year) \_\_\_\_\_ under the business name of Mide Connections by (signature) Jim Vicks Kuhl