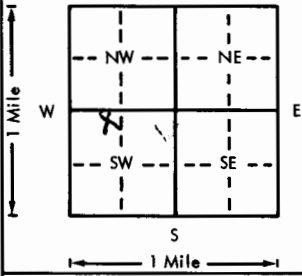


USE TYPEWRITER OR BALL
POINT PEN-PRESS FIRMLY,
PRINT CLEARLY.

WATER WELL RECORD
KSA 82a-1201-1215

Kansas Department of Health and
Environment-Division of Environment
(Water well Contractors)
Topeka, Kansas 66620

1. Location of well:	County Haskell	Fraction NE 1/4 NW 1/4 SW 1/4	Section number 9	Township number T 30 S R 34	Range number 34
2. Distance and direction from nearest town or city: 2 NW., 1 W., 1/2 N., 1/2 E. of Satanta.		3. Owner of well: Rooney Ranch R.R. or street: City, state, zip code: Satanta, Ks. 67870			
4. Locate with "X" in section below: 		Sketch map:		6. Bore hole dia. 26 in. Completion date 3-3-77 Well depth 500 ft.	
5. Type and color of material		From	To	7. <input type="checkbox"/> Cable tool <input type="checkbox"/> Rotary <input type="checkbox"/> Driven <input type="checkbox"/> Dug <input type="checkbox"/> Hollow rod <input type="checkbox"/> Jetted <input type="checkbox"/> Bored <input checked="" type="checkbox"/> Reverse rotary	
				8. Use: <input type="checkbox"/> Domestic <input type="checkbox"/> Public supply <input type="checkbox"/> Industry <input checked="" type="checkbox"/> Irrigation <input type="checkbox"/> Air conditioning <input type="checkbox"/> Stock <input type="checkbox"/> Lawn <input type="checkbox"/> Oil field water <input type="checkbox"/> Other	
				9. Casing: Material steel Height: Above surface Threaded <input type="checkbox"/> Welded <input checked="" type="checkbox"/> Surface 12 in. RMP <input type="checkbox"/> PVC <input type="checkbox"/> Weight 36.87 lbs./ft. Dia. 16 in. to 501 ft. depth Wall Thickness: inches or Dia. <input type="checkbox"/> in. to <input type="checkbox"/> ft. depth gauge No. 250	
				10. Screen: Manufacturer's name Johnson Type galv. Dia. 16" Slot 1/8" Length 5000 ft. Set between 410 ft. and 470 ft. Perf: 260-410 ft. and 470-500 ft. Gravel pack? yes Size range of material 1/2" down	
				11. Static water level: 210 ft. below land surface Date 2-15-77 mo./day/yr.	
				12. Pumping level below land surfaces: 275 ft. after 2 hrs. pumping 1300 g.p.m. ft. after hrs. pumping g.p.m. Estimated maximum yield 1400 g.p.m.	
				13. Water sample submitted: Yes <input checked="" type="checkbox"/> No <input type="checkbox"/> Date	
				14. Well head completion: <input type="checkbox"/> Pitless adapter 12 inches above grade	
				15. Well grouted? yes With: <input type="checkbox"/> Neat cement <input type="checkbox"/> Bentonite <input checked="" type="checkbox"/> Concrete Depth: From 0 ft. to 10 ft.	
				16. Nearest source of possible contamination: N/A ft. Direction Type Well disinfected upon completion? <input type="checkbox"/> Yes <input checked="" type="checkbox"/> No	
				17. Pump: Not installed Manufacturer's name Goody Model number 125 HP 2.5 Volts Length of drop pipe 400 ft. capacity 1200 g.p.m. Type: <input type="checkbox"/> Submersible <input checked="" type="checkbox"/> Turbine <input type="checkbox"/> Jet <input type="checkbox"/> Reciprocating <input type="checkbox"/> Centrifugal <input type="checkbox"/> Other	
				(Use a second sheet if needed)	
18. Elevation: Topography: <input type="checkbox"/> Hill <input checked="" type="checkbox"/> Slope <input type="checkbox"/> Upland <input type="checkbox"/> Valley	19. Remarks: 20. Water well contractor's certification: This well was drilled under my jurisdiction and this report is true to the best of my knowledge and belief. Minter-Wilson Drilling Co. 208 Business name License No. Address Box A Garden City, Ks. Signed Robert L. Kaper Date 3-30-77 Authorized representative				

Forward the white, blue and pink copies to the Department of Health and Environment

Form WWC-5

The Professionals

HINTER-WILSON DRILLING CO.

INCORPORATED

Irrigation
and Domestic
Water Systems
Complete Installation
and Repairing

Phone 276-8269 • P.O. Box A • GARDEN CITY, KANSAS 67840

ROONEY RANCH INC.

HASKELL COUNTY

2/15/77

Location: SW 9-31-34 south of Ryus to Rooney's house
190 south 1/2 east

Static Water Level- 210

Test #1

0	4	Top soil
4	12	Brown clay
12	67	Fine sand
67	82	Brown clay
82	163	Fine to med. sand and gravel
163	202	Brown clay
202	233	Fine to med. sand and gravel
233	247	Brown clay
247	470	Fine to med. sand and gravel
470	487	Fine to med. sand and gravel 10% clay
487	491	Brown clay
491	496	Brown and yellow clay and white rock hard
496	500	Shale

T.D. 500