


1 LOCATION OF WATER WELL:	Fraction	center	Section Number	Township Number	Range Number
County: Haskell	1/4	1/4 NE 1/4	10	T 30 S	R 34 E/W

Distance and direction from nearest town or city street address of well if located within city?
From Satanta 1½ North 1 West on South Side

2 WATER WELL OWNER:	Sig Doris	
RR#, St. Address, Box # :	RFD 1	Board of Agriculture, Division of Water Resources
City, State, ZIP Code :	Satanta, KS 67870	Application Number:

LOCATE WELL'S LOCATION WITH AN "X" IN SECTION BOX: 4 DEPTH OF COMPLETED WELL: 470 ft. ELEVATION: _____

Depth(s) Groundwater Encountered 1. 132 ft. 2. _____ ft. 3. _____ ft.

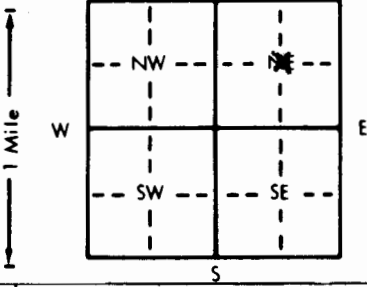

4 DEPTH OF COMPLETED WELL 470 ft. ELEVATION: _____

Depth(s) Groundwater Encountered 1. 132 ft. 2. _____ ft. 3. _____ ft.

WELL'S STATIC WATER LEVEL 338 ft. below land surface measured on mo/day/yr 5-20-91

Pump test data: Well water was 357 ft. after 2 hours pumping 25 gpm

Est. Yield 30 gpm: Well water was _____ ft. after _____ hours pumping _____ gpm

Bore Hole Diameter 9 in. to 470 ft., and _____ in. to _____ ft.

WELL WATER TO BE USED AS:

<u>1</u> Domestic	3 Feedlot	6 Oil field water supply	8 Air conditioning	11 Injection well
2 Irrigation	4 Industrial	7 Lawn and garden only	9 Dewatering	12 Other (Specify below)

Was a chemical/bacteriological sample submitted to Department? Yes _____ No X; If yes, mo/day/yr sample was submitted _____

Water Well Disinfected? Yes X No _____

5	TYPE OF BLANK CASING USED:		5 Wrought iron	8 Concrete tile	CASING JOINTS: Glued <input checked="" type="checkbox"/> Clamped Welded Threaded
	1 Steel	3 RMP (SR)	6 Asbestos-Cement	9 Other (specify below)	
	2 PVC	4 ABS	7 Fiberglass		

Blank casing diameter 5 in. to 390 ft. Dia in. to ft. Dia in. to ft.
Casing height above land surface 14 in., weight 200 lbs./ft. Wall thickness or gauge No. 0.265

TYPE OF SCREEN OR PERFORATION MATERIAL:			7 PVC	10 Asbestos-cement
1 Steel	3 Stainless steel	5 Fiberglass	8 RMP (SR)	11 Other (specify)
2 Brass	4 Galvanized steel	6 Concrete tile	9 ABS	12 None used (open hole)

SCREEN OR PERFORATION OPENINGS ARE:		5 Gauzed wrapped	8 Saw cut	11 None (open hole)
<u>1 Continuous slot</u>	3 Mill slot	6 Wire wrapped	9 Drilled holes	
2 Louvered shutter	4 Key punched	7 Torch cut	10 Other (specify)	

SCREEN-PERFORATED INTERVALS:	From	390	ft. to	470	ft., From	ft. to	ft.
	From		ft. to		ft., From	ft. to	ft.
GRAVEL PACK INTERVALS:	From	330	ft. to	470	ft., From	ft. to	ft.
	From		ft. to		ft., From	ft. to	ft.

6 GROUT MATERIAL: 1 Neat cement 2 Cement grout 3 Bentonite 4 Other

Grout Intervals: From ft. to ft., From ft. to ft., From ft. to ft.

What is the nearest source of possible contamination:				10 Livestock pens	14 Abandoned water well
1 <u>Septic tank</u>	4 Lateral lines	7 Pit privy	11 Fuel storage	15 Oil well/Gas well	
2 Sewer lines	5 Cess pool	8 Sewage lagoon	12 Fertilizer storage	16 Other (specify below)	
3 Watertight sewer lines	6 Seepage pit	9 Feedyard	13 Insecticide storage	

Direction from well?		North		How many feet?		500	
FROM	TO	LITHOLOGIC LOG	FROM	TO	PLUGGING INTERVALS		

[illegible]

7. CONTRACTOR'S OR LANDOWNER'S CERTIFICATION: This water well was (1) constructed, (2) reconstructed, or (3) plugged under my jurisdiction and was completed on (mo/day/year) 5-20-91 and this record is true to the best of my knowledge and belief. Kansas Water Well Contractor's License No. 142 This Water Well Record was completed on (mo/day/yr) 5-21-91 under the business name of T & W Water Well Service, Inc. by (signature) C.D. Wagenseil