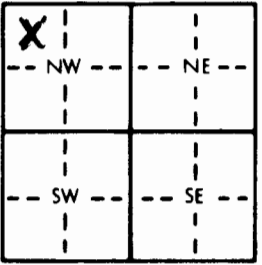
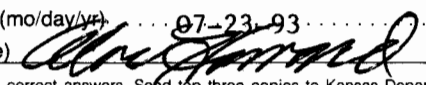


1 LOCATION OF WATER WELL: County: <b>HASKEL</b>		Fraction <b>C 1/4 NW 1/4 NW 1/4</b>	Section Number <b>11</b>	Township Number <b>T 30S S</b>	Range Number <b>R 34W EW</b>	
Distance and direction from nearest town or city street address of well if located within city? <b>7 1/2 MILES SW OF SUBLETE, KS</b>	
2 WATER WELL OWNER: <b>OXY USA, INC.</b> RR#, St. Address, Box #: <b>BOX 26100</b> City, State, ZIP Code: <b>OKLAHOMA CITY, OK 73126-0100</b>			#1 <b>HUXMAN A MLP</b> Board of Agriculture, Division of Water Resources Application Number: <b>930241</b>	
3 LOCATE WELL'S LOCATION WITH AN "X" IN SECTION BOX: 		4 DEPTH OF COMPLETED WELL: <b>400</b> ft. ELEVATION: Depth(s) Groundwater Encountered 1. <b>305</b> ft. 2. ft. 3. ft. WELL'S STATIC WATER LEVEL <b>305</b> ft. below land surface measured on mo/day/yr <b>07-23-93</b> Pump test data: Well water was <b>356</b> ft. after <b>1</b> hours pumping <b>100</b> gpm Est. Yield <b>100</b> gpm: Well water was ft. after hours pumping gpm Bore Hole Diameter <b>11</b> in. to <b>805x 400</b> ft., and in. to ft. WELL WATER TO BE USED AS: 5 Public water supply 8 Air conditioning 11 Injection well 1 Domestic 3 Feedlot 6 Oil field water supply 9 Dewatering 12 Other (Specify below) 2 Irrigation 4 Industrial 7 Lawn and garden only 10 Monitoring well Was a chemical/bacteriological sample submitted to Department? Yes No <b>X</b> ; If yes, mo/day/yr sample was submitted Water Well Disinfected? Yes <b>X</b> No	
5 TYPE OF BLANK CASING USED: 1 Steel 3 RMP (SR) 5 Wrought iron 8 Concrete tile CASING JOINTS: Glued <b>X</b> Clamped 2 PVC 4 ABS 400 6 Asbestos-Cement 9 Other (specify below) Welded Blank casing diameter <b>6</b> in. to <b>305</b> ft., Dia. in. to ft., Dia. in. to ft. Casing height above land surface <b>24</b> in., weight <b>2,902</b> lbs./ft. Wall thickness or gauge No. <b>280 SDR 21</b> TYPE OF SCREEN OR PERFORATION MATERIAL: 7 PVC 10 Asbestos-cement 1 Steel 3 Stainless steel 5 Fiberglass 8 RMP (SR) 11 Other (specify) 2 Brass 4 Galvanized steel 6 Concrete tile 9 ABS 12 None used (open hole) SCREEN OR PERFORATION OPENINGS ARE: 5 Gauzed wrapped 8 Saw cut 11 None (open hole) 1 Continuous slot 3 Mill slot 6 Wire wrapped 9 Drilled holes 2 Louvered shutter 4 Key punched 7 Torch cut 10 Other (specify) SCREEN-PERFORATED INTERVALS: From <b>300</b> ft. to <b>400</b> ft., From ft. to ft. GRAVEL PACK INTERVALS: From <b>200</b> ft. to <b>400</b> ft., From ft. to ft. From ft. to ft., From ft. to ft.	
6 GROUT MATERIAL: 1 Neat cement 2 Cement grout 3 Bentonite 4 Other <b>HOLE PLUG</b> Grout Intervals: From <b>1</b> ft. to <b>20</b> ft., From ft. to ft., From ft. to ft. What is the nearest source of possible contamination: 1 Septic tank 4 Lateral lines 7 Pit privy 10 Livestock pens 14 Abandoned water well 2 Sewer lines 5 Cess pool 8 Sewage lagoon 11 Fuel storage 15 Oil well/Gas well 3 Watertight sewer lines 6 Seepage pit 9 Feedyard 12 Fertilizer storage 16 Other (specify below) 13 Insecticide storage Direction from well? <b>NORTHWEST</b> How many feet? <b>150</b>	
<table border="1"><thead><tr><th>FROM</th><th>TO</th><th>LITHOLOGIC LOG</th><th>FROM</th><th>TO</th><th>PLUGGING INTERVALS</th></tr></thead><tbody><tr><td>0</td><td>20</td><td>TOP SOIL &amp; SAND</td><td>260</td><td>280</td><td>FINE SAND &amp; CLAY</td></tr><tr><td>20</td><td>40</td><td>CLAY &amp; SAND</td><td>280</td><td>295</td><td>BOTTOM MOSTLY CLAY "BLUE GRAY"</td></tr><tr><td>40</td><td>50</td><td>SANDY CLAY &amp; LIME STONE</td><td>295</td><td>315</td><td>FINE SAND</td></tr><tr><td>50</td><td>60</td><td>SANDY CLAY</td><td>315</td><td>330</td><td>FINE TO MED SAND</td></tr><tr><td>60</td><td>80</td><td>COARSE SAND W/ CLAY</td><td>330</td><td>330</td><td>FINE SAND &amp; CLAY</td></tr><tr><td>80</td><td>100</td><td>COARSE SAND</td><td>330</td><td>345</td><td>FINE TO MED SAND</td></tr><tr><td>100</td><td>115</td><td>SANDY CLAY &amp; GRAVEL</td><td>345</td><td>350</td><td>GRAY BLUE CLAYMOSTLY W/ FINE SAND</td></tr><tr><td>115</td><td>120</td><td>COARSE SAND</td><td>350</td><td>360</td><td>FINE TO MED SAND</td></tr><tr><td>120</td><td>140</td><td>COARSE SAND USING ALOT OF WATER</td><td>360</td><td>380</td><td>FINE SANDY CLAY</td></tr><tr><td>140</td><td>200</td><td>COARSE SAND</td><td>380</td><td>400</td><td>FINE SANDY CLAY</td></tr><tr><td>200</td><td>210</td><td>SAND GETTING FINE</td><td></td><td></td><td></td></tr><tr><td>210</td><td>235</td><td>COARSE &amp; FINE SAND</td><td></td><td></td><td></td></tr><tr><td>235</td><td>240</td><td>SAND &amp; WHT CLAY MAKING WATER</td><td></td><td></td><td></td></tr><tr><td>240</td><td>250</td><td>FINE SAND W/ STREAKS OF BLUE GRAY CLAY</td><td></td><td></td><td></td></tr><tr><td>250</td><td>260</td><td>FINE TO MED SAND</td><td></td><td></td><td></td></tr>
7 CONTRACTOR'S OR LANDOWNER'S CERTIFICATION: This water well was (1) constructed, (2) reconstructed, or (3) plugged under my jurisdiction and was completed on (mo/day/year) <b>07-23-93</b> and this record is true to the best of my knowledge and belief. Kansas Water Well Contractor's License No. <b>KWWCL-430</b> This Water Well Record was completed on (mo/day/yr) <b>07-23-93</b> under the business name of <b>HOWARD DRLG. CO. BOX 806 BEAVER, OK 73932</b> by (signature) 	
INSTRUCTIONS: Use typewriter or ball point pen. PLEASE PRESS FIRMLY and PRINT clearly. Please fill in blanks, underline or circle the correct answers. Send top three copies to Kansas Department of Health and Environment, Bureau of Water, Topeka, Kansas 66620-0001. Telephone: 913-296-5545. Send one to WATER WELL OWNER and retain one for your records.	